


DATE 4/10/2020

TOWN OF LEXINGTON — BOARD OF PUBLIC WORKS
WATER DIVISION

Sketch of Service Here

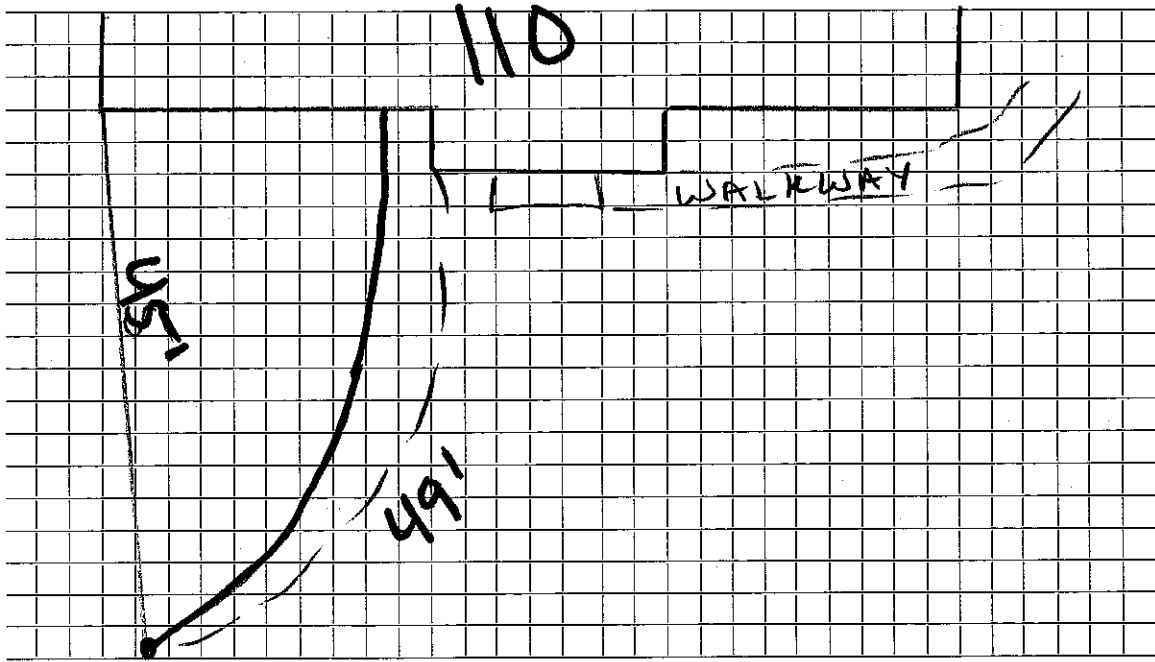

1" curb stop

Connection made in WOOD Street. Work completed

Remarks: