




DATE \_\_\_\_\_

# TOWN OF LEXINGTON — BOARD OF PUBLIC WORKS

## WATER DIVISION

Sketch of Service Here

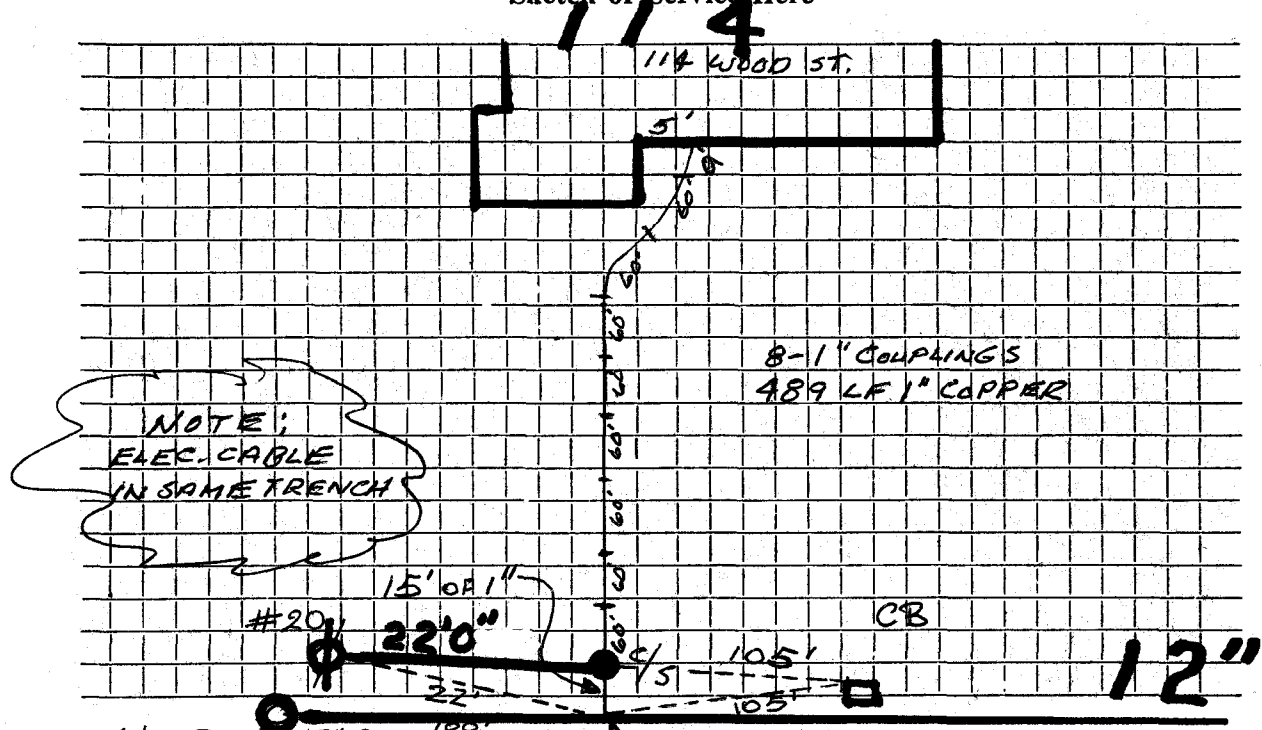

Connection made in WOOD 12" Gate Street. Work completed 1" COP

Remarks: .....

.....

.....