

WATER SERVICE RECORD

2036
2037

Name William Kennedy

Service No. 20

Address 135 Wood Street

Location

Repair—Renewal—New Service ~~XXXXXXXX~~ w.o. # 7817 Ferrari #1608

SEP 21 1970


Date	Material	Amount	Total	Date	Amount
6/12/70	Labor	84 06		6-3-70	260 00
6/15/70	"	43 44	127 50	7-21-70	36 67
	10% O.H.		12 75		223 33
21'	3/4" Copper pipe	79	16 59	8/6/90	24' - 1" COPPER
1	3/4" Corporation		9 57		1" CORP
1	3/4" Curb cock		11 32		1" CURB
	Box & Rod		5 10		1" X 3/4 Union
1/2	Ton cold Patch 6.00		3 00		
2	Ton hot top 6.00		12 00		
3	Hrs. Shovel 6.50		19 50		
2	Hrs. Trucking 3.00		6 00		
			223 33		
6/23/70	93' 3/4" Copper tubing				

DATE _____

TOWN OF LEXINGTON — BOARD OF PUBLIC WORKS

WATER DIVISION

Sketch of Service Here

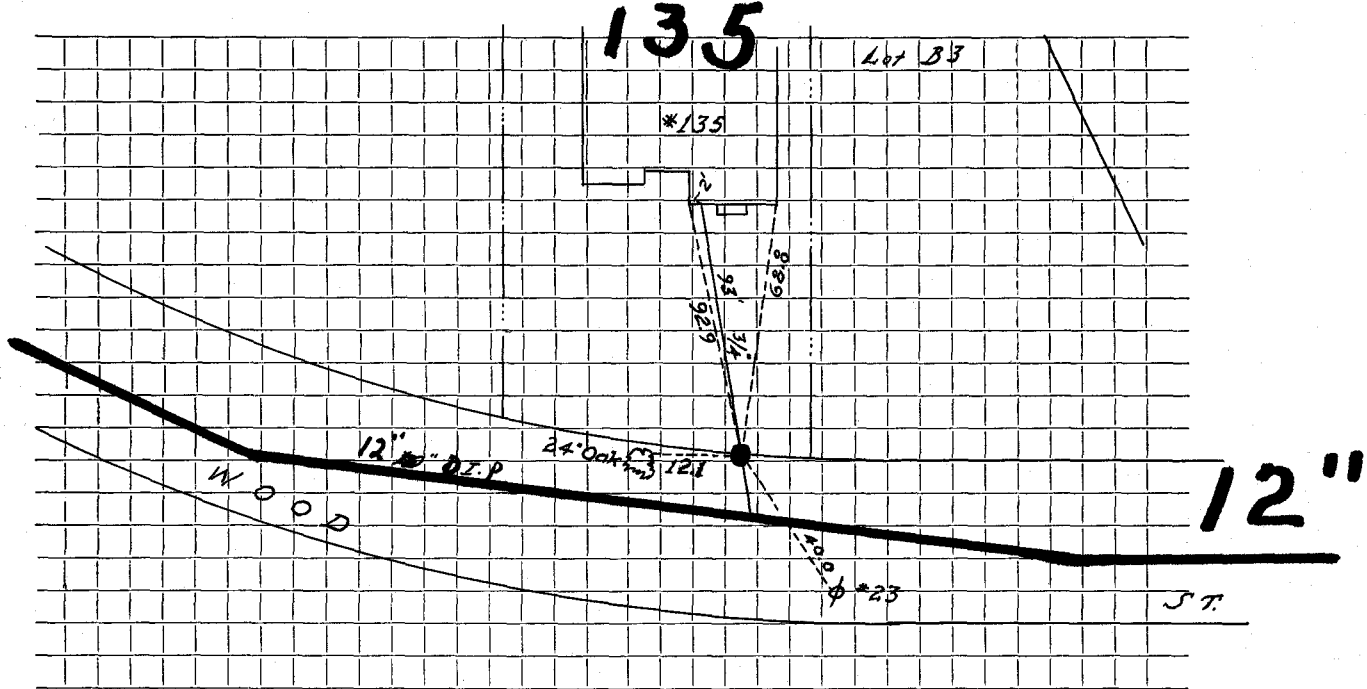

Connection made in Street. Work completed

Remarks:
.....
.....