




DATE 9/3/2020

TOWN OF LEXINGTON — BOARD OF PUBLIC WORKS

WATER DIVISION

Sketch of Service Here

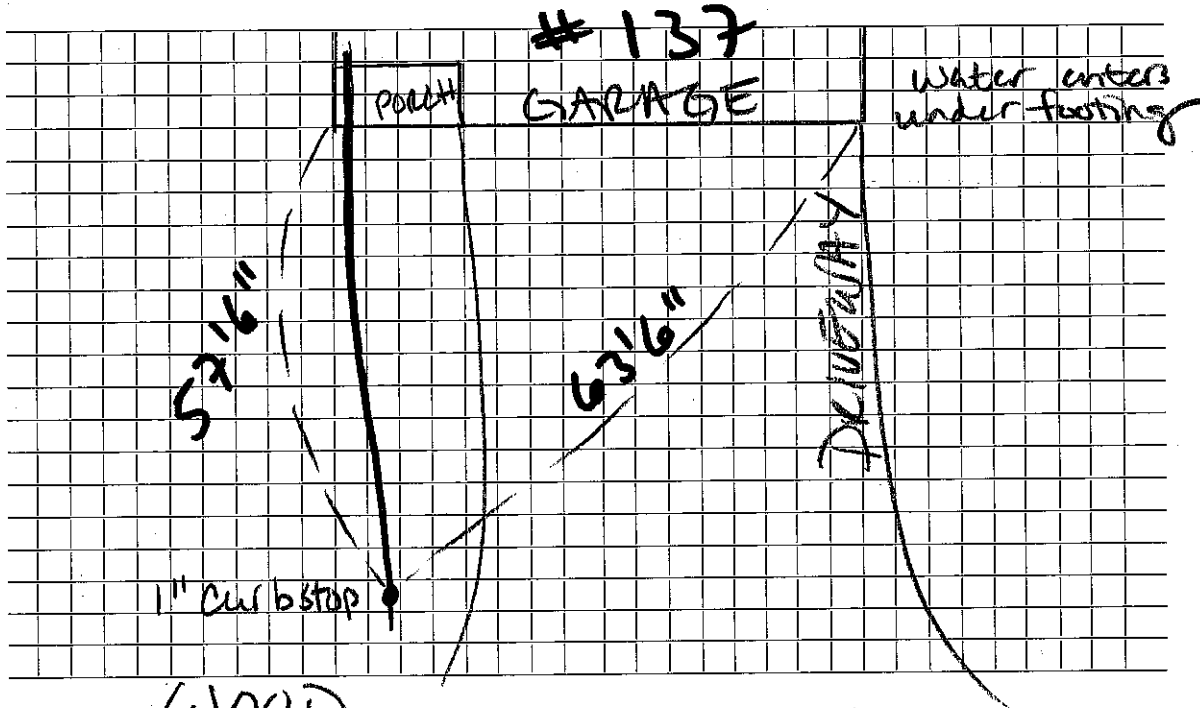

Connection made in ..... WOOD ..... Street. Work completed .....

Remarks: ..... new buffalo box 4'10" cover .....