

Name

Vincent Broyna

Service No.

79 3039

Address

73 Tremont St., Boston

#5547

Location/39 Wood St.

Kind of Pipe

Size

Size of Main

~~Repair~~ ~~Renewal~~ New Service

Location

Date	Material	Amount	Total	Date	Amount
12-31-32 Cons. for 10. 5-8-33	Building fit, & installing fit, & cover	\$ 10 -		Nov. 19 1932 - Cash	10 -
	Labor			8/7/90 28'-1" COPPER 1" CORP 1" Curb 1" x 3/4 Union Box + Rod	

Hadley Press, Inc., Lexington

DATE _____

TOWN OF LEXINGTON—BOARD OF PUBLIC WORKS

WATER DIVISION

The undersigned applies for a supply of water at No. _____ St. and hereby agrees to comply with the rules and regulations as now, or at any future time, established by the Board of Selectmen.

Am't. of Estimate \$ _____


Owner _____

Am't. Paid \$ _____

Address _____

Builder _____

Sketch of Service Here

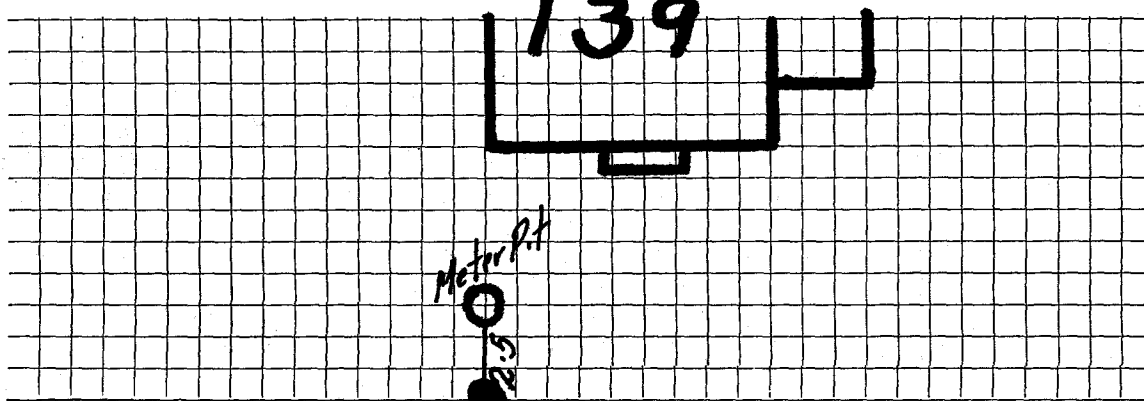

Connection made in _____

Street.

Work completed _____

19

Remarks: