

Name Ernest K. Ballard

Service No. 3040

6630

Address 148 Wood Street

Location

"MAKING CONNECTION" 148 Wood Street

"Trench & Pipe by owner"

Kind of Pipe

Size

Size of Main

~~Repair~~ ~~Renewal~~ - New Service

Location

Date		Material	Amount	Total	Date		Amount
1/15/31	7	Hrs. Labor @.55	3 85				
1/4-14-31	2	" " @.60	1 20	\$5 05	Nov. 7 1931	Cash	5 81
		15% Overhead		76			
				\$5 81	APR 1-31		
					MAY 1-15-31		
					AUG 1-31		
		Labor			8/7/90	13'-1" COPPER 1" CORP 1" CURB 1"X2" INCREASER 1'-2" COPPER 1-2" Union	

Hadley Press, Inc., Lexington

DATE _____

TOWN OF LEXINGTON—BOARD OF PUBLIC WORKS

WATER DIVISION

The undersigned applies for a supply of water at No. _____ St. and hereby agrees to comply with the rules and regulations as now, or at any future time, established by the Board of Selectmen.


Am't. of Estimate \$ _____

Owner _____

Am't. Paid \$ _____

Address _____

Builder _____

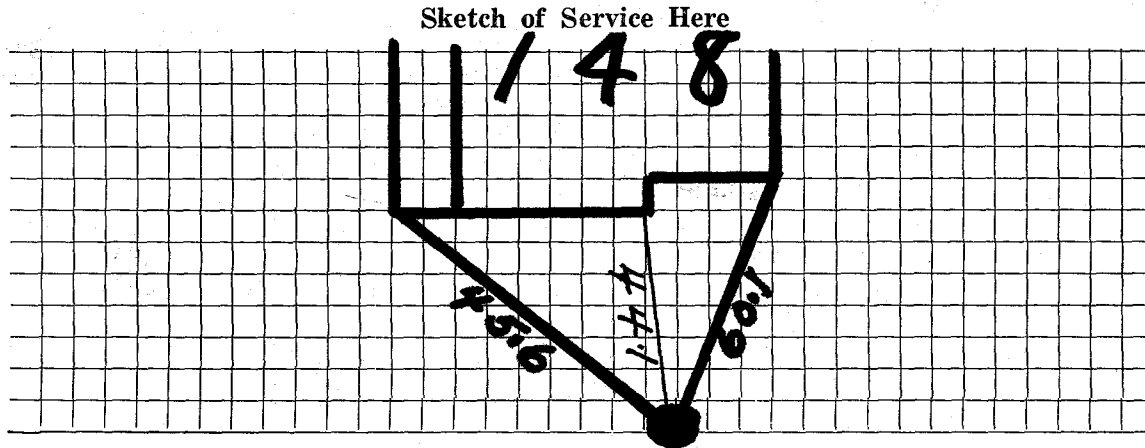

Connection made in _____ Street.

Work completed _____ 19

Remarks: