

WATER SERVICE RECORD

2276

Name Gail Smith

Service No. 49

Address 164 Wood Street

Location Lexington, Mass.

Repair ~~Renewal~~ - New Service


Com. 5-21-51

Date	Material	Amount	Total	Date	Amount
4-9-51	Labor	1 49	1 49	April 5 '57	30 00
	10% Overhead		15	June 19 '51	14 03
	72' - 3/4" Copper Tubing @ .36	25 92			No Charge
	1 - 3/4" C x 1/2" I.W.H. S&W	4 00		4-9-51	Labor
	1 - 3/4" C x 3/4" Union (3pts)	1 72			5 10
	Trucking 1 hr. @ .75	75			4 33
	Patching 10 x 3	10 00			4 67
		44 03			4 68
	<i>Bill sent 6-13-51</i>				50
					50
					14 00
					75
				8/7/90	39 08
					1" - CORP
					1" - Curb
					1" x 3/4 Union

DATE _____

TOWN OF LEXINGTON — BOARD OF PUBLIC WORKS
WATER DIVISION

Sketch of Service Here

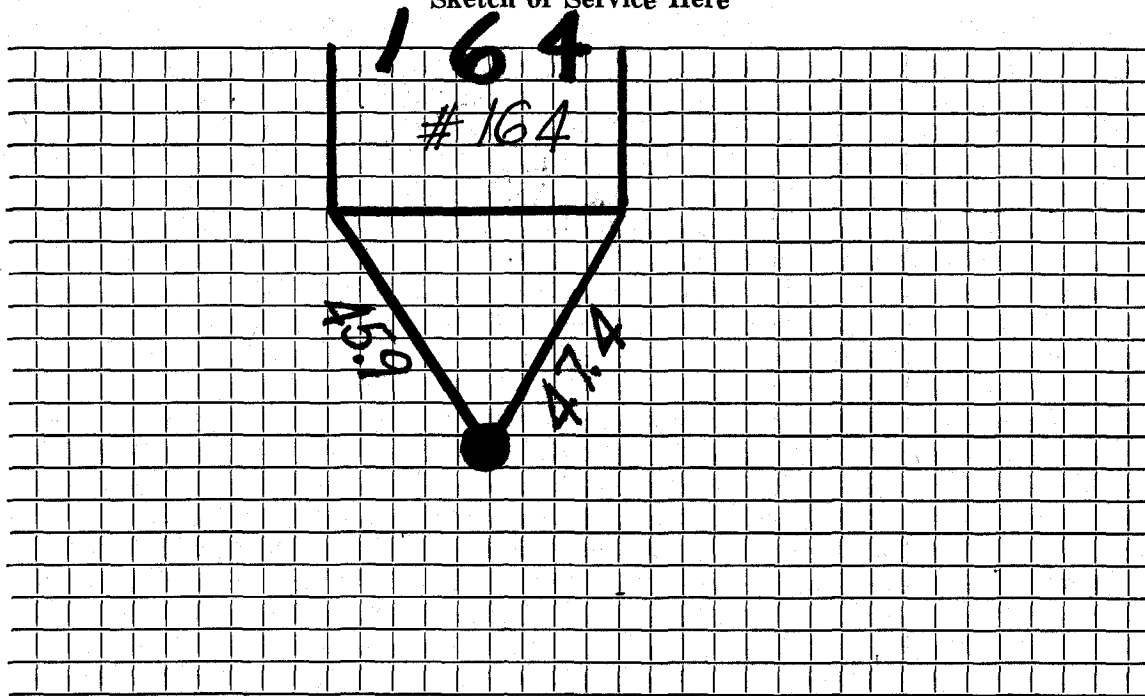

Connection made in Street. Work completed

Remarks:
.....
.....