

WATER SERVICE RECORD

#2975

Name Earl Outnet

Service No. 8

Address 165 Wood Street

Location

~~Repair~~ ~~Contract~~ - New Service DeFlice #974 W.O.#6501

AUG 5 1968


Date	Material	Amount	Total	Date	Amount
4-17-68	Labor	5.24		4-15-68	360.08
4-18-68	"	47.88		8-5-68	197.18
4-25-68	"	15.07	68.19		162.82
	10% O.H.	6.82	75.01		
	23' 3/4" Copper tubing @79		18.17	8/9/90	32' - 1" COPPER
	1 3/4" Corp Cock		7.42		1" CORR
	1 3/4" Curb Cock		11.32		1" CURB
	1 Box & Rod		5.10		1" x 3/4 Unions
	1/2 ton Cold Patch @5.50		2.75		
	1 ton Hot Top		5.80		
	4 hrs. Trucking @3.00		12.00		
	2 hrs. Town Shovel @6.50		13.00		
	1 3/4 hr Compressor @5.00		8.75		
	1/2 hr. Roller		1.50		
	1/2 hr. Trailer		2.00		
			162.82		
4-29-68	46' 3/4" Copper tubing				
				* Applied to WTC Misc #6	173.61

DATE _____

TOWN OF LEXINGTON — BOARD OF PUBLIC WORKS

WATER DIVISION

Sketch of Service Here

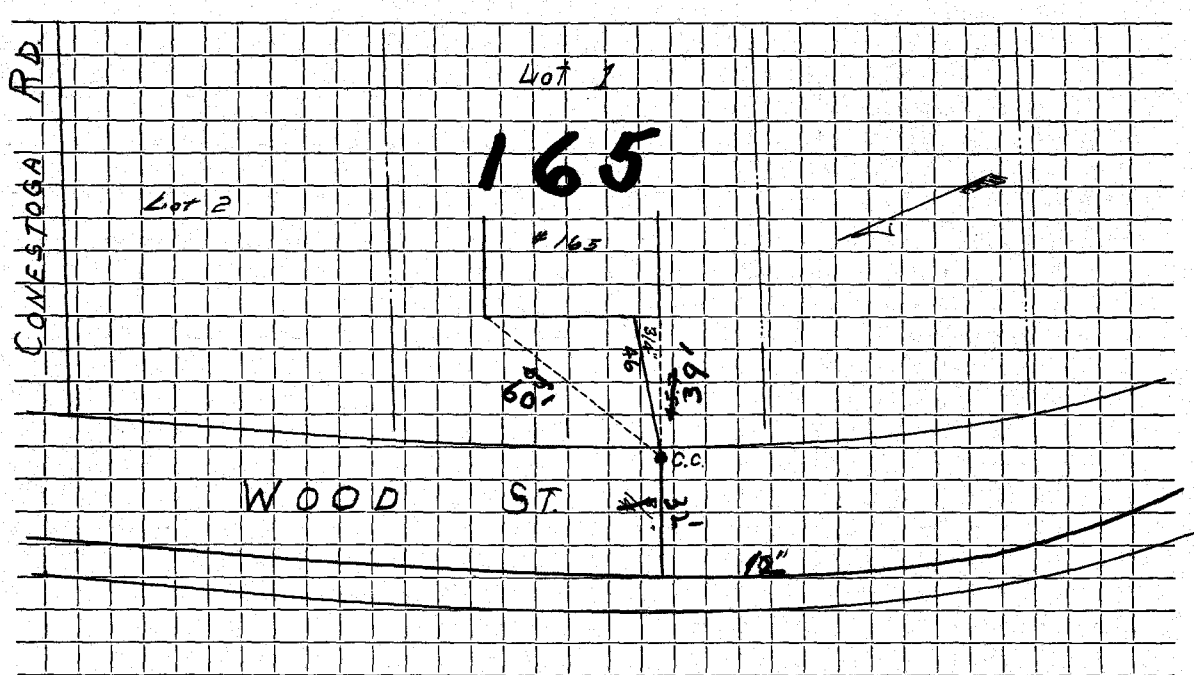

Connection made in Street. Work completed

Remarks:

.....

.....