


DATE 12/13/90

TOWN OF LEXINGTON — BOARD OF PUBLIC WORKS

WATER DIVISION

Sketch of Service Here

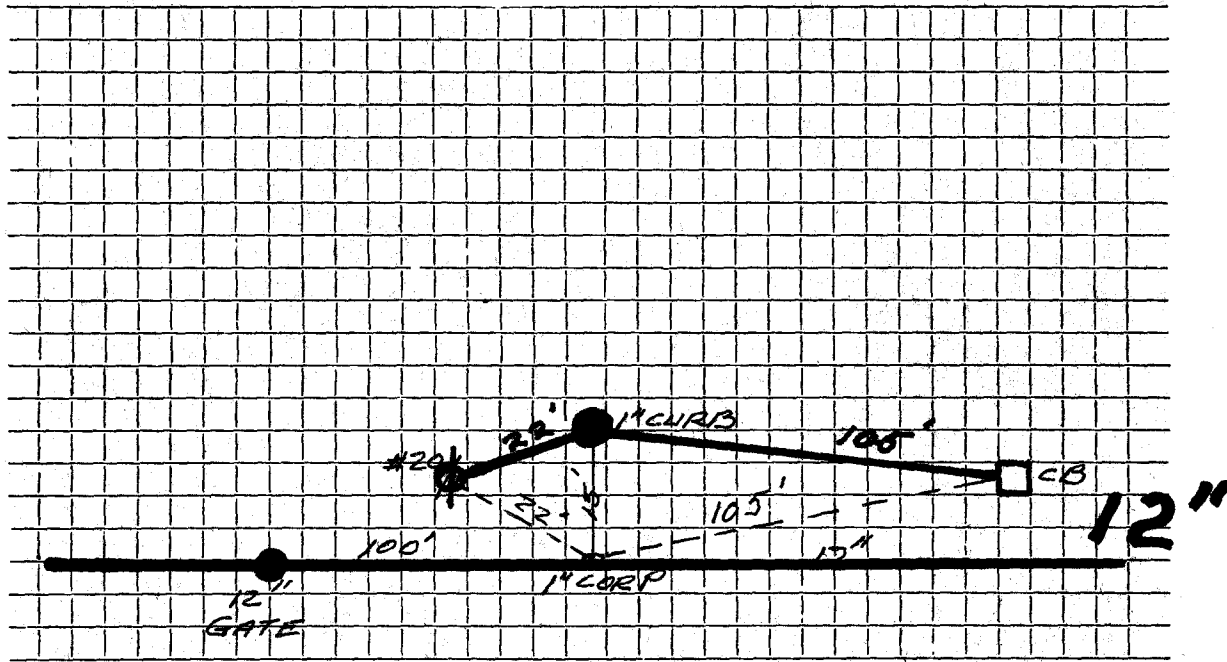

Connection made in WOOD Street. Work completed

Remarks: NEW HOUSE SERV.