

#4355

WATER SERVICE RECORD

Service No. 1

Name H. A. McLaughlin

Address 180 Wood Street

Location

Repair ~~Renewal~~ - New Service


Date	Material	Amount	Total	Date	Amount
2/16/56	Labor	36 77		1-3-56 Deposit	100 00
	10% overhead	3 68	40 45	6-18-56 Paid	56 15
	65' 3/4" Copper tubing @ .4995		32 47		NON CHARGE
	1 - 3/4Cx3/4C Union (3 pt.)		1 77	4/3/56 Labor	7.10
	1-3/4Cx1/2 E.W.H. Stop & Waste		4 96	4/4/56 "	15.60
	12x3 patching		12 00	<del>21-3/4" Copper tubing @ .4995</del>	10 49
	1 hr. Trucking		75	<del>1-3/4" C. Corp Cock</del>	4 34
	7 1/2 hrs. Littlefield Shovel @ 8.50		63 75	<del>1-3/4" Curb Cock</del>	6 03
			156 15	1 Box & Rod	4 62
				1 - 1/2" Straight tailpiece	50
				1 - 1/2" Offset tailpiece	50
				3 1/2 hrs. Littlefield Shovel @ 8.50	29.75
				8/20/90 15'-1" COPPER	
				1" CORP	
				1" CURB	
				Bill sent 5-22-56	
				1" x 3/4 UNION	

DATE \_\_\_\_\_

TOWN OF LEXINGTON — BOARD OF PUBLIC WORKS

**WATER DIVISION**

Sketch of Service Here

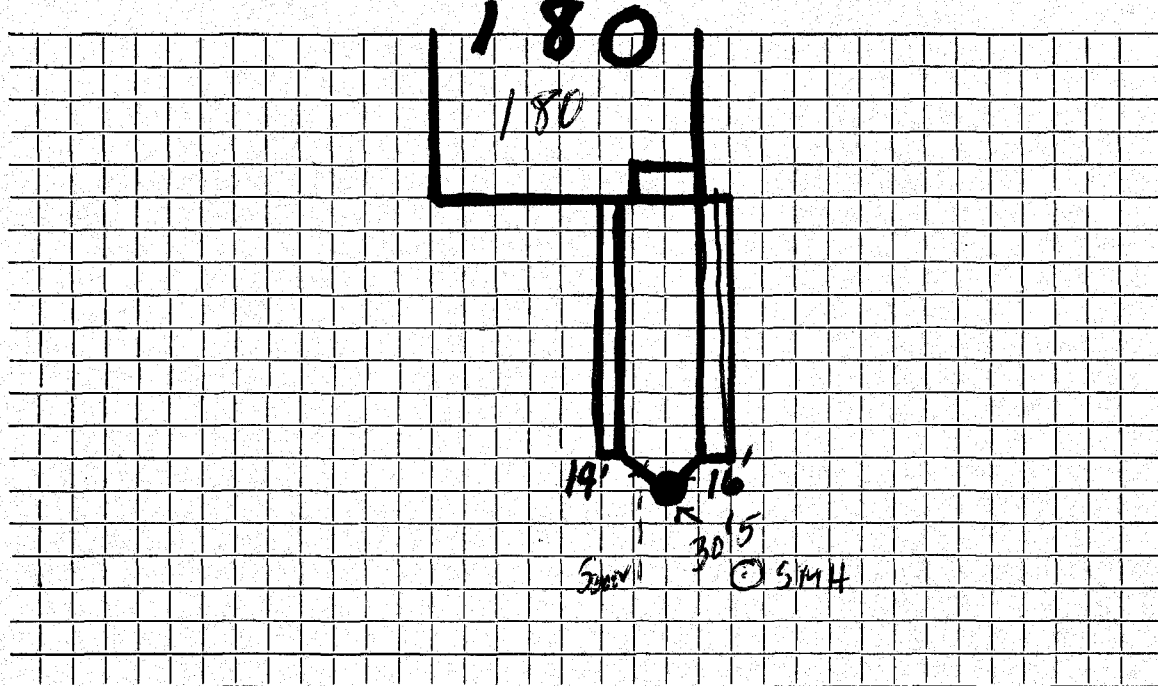

Connection made in ..... Street. Work completed .....

Remarks: .....

.....

.....