


DATE 10-23-2001

TOWN OF LEXINGTON — BOARD OF PUBLIC WORKS

WATER DIVISION

Sketch of Service Here

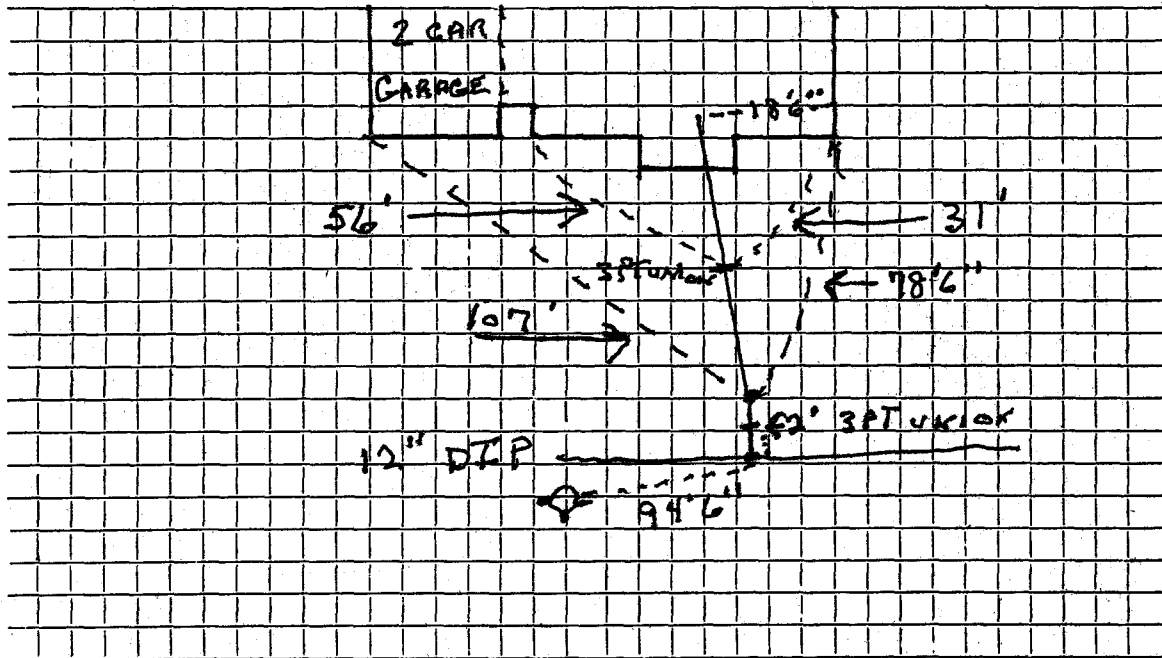

Connection made in ... wood Street. Work completed

Remarks: INSTALLED BY J. McLAUGHLIN