

Name Arthur H. Earle

Service No. 3 3045

Address ~~255~~ Columbus Ave., Boston

#201 Wood St
(Wright, Wood St.)

Location

Kind of Pipe

Size

Size of Main

Repair-Renewal-New Service

Location

| Date | Material | Amount | Total | Date | Amount |
|------------|--------------------------|--------|---------|----------------------|-----------------------------|
| P. 4-14-31 | 41' 1" C.L. Pipe @ .27 | 11 07 | | | |
| | 2 1" L.L. Coupling @ .25 | 50 | | March 25 1931 - Cash | 60 |
| | 1 1" L.L. Ell | 35 | | | |
| | 1 1" Br. Sp. Nip. | 20 | | | |
| | 1 S & W | 3 00 | | 8/20/90 | 25' - 1" COPPER |
| | Trucking | 75 | \$15 87 | | 1" CORP |
| | | | | | 1" CURB |
| 4/4/31 | 40 Hrs. Labor @ .55 | 22 00 | | | 1" PIPE COUPLING |
| | 2 " " @ .60 | 1 20 | 23 20 | | |
| | 15% Overhead | | 3 48 | | |
| | Cost | | 42 55 | | |
| Charge | 40' Labor @ 1.50 | 60 00 | 60 00 | | |

Hadley Press, Inc., Lexington

DATE _____

TOWN OF LEXINGTON—BOARD OF PUBLIC WORKS

WATER DIVISION

The undersigned applies for a supply of water at No. (Lot #2-Bungalow #2) Wood St. and hereby agrees to comply with the rules and regulations as now, or at any future time, established by the Board of Selectmen.

Am't. of Estimate \$ 60


Owner Arthur H. Earle

Am't. Paid \$ _____

Address 285 Columbus Avenue

Builder _____

Boston

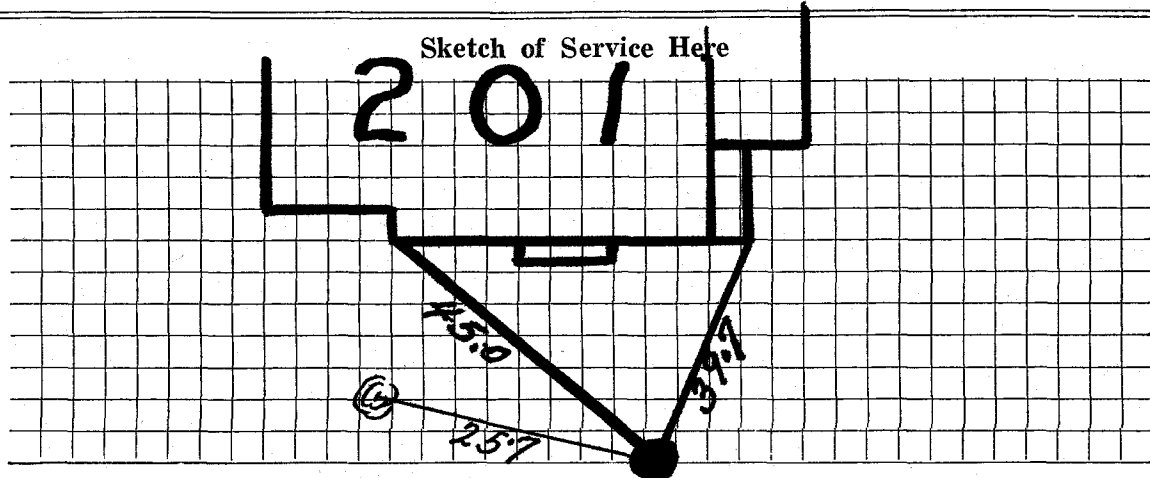

Connection made in _____ Street.

Work completed _____ 19

Remarks: