

WATER SERVICE RECORD

Name

Service No.

Address

205 Wood St

Location

Repair—Renewal—New Service


Date	Material	Amount	Total	Date	Amount
2-28-01	SERVICE RENEWED INSIDE			8-20-90	20' 1" Copper 1" - cap 1" - curb
	39' 3" - 1" Copper				
	1- 1" 3pt union				
	1- Buffalo Box				

DATE \_\_\_\_\_

TOWN OF LEXINGTON — BOARD OF PUBLIC WORKS

**WATER DIVISION**

Sketch of Service Here

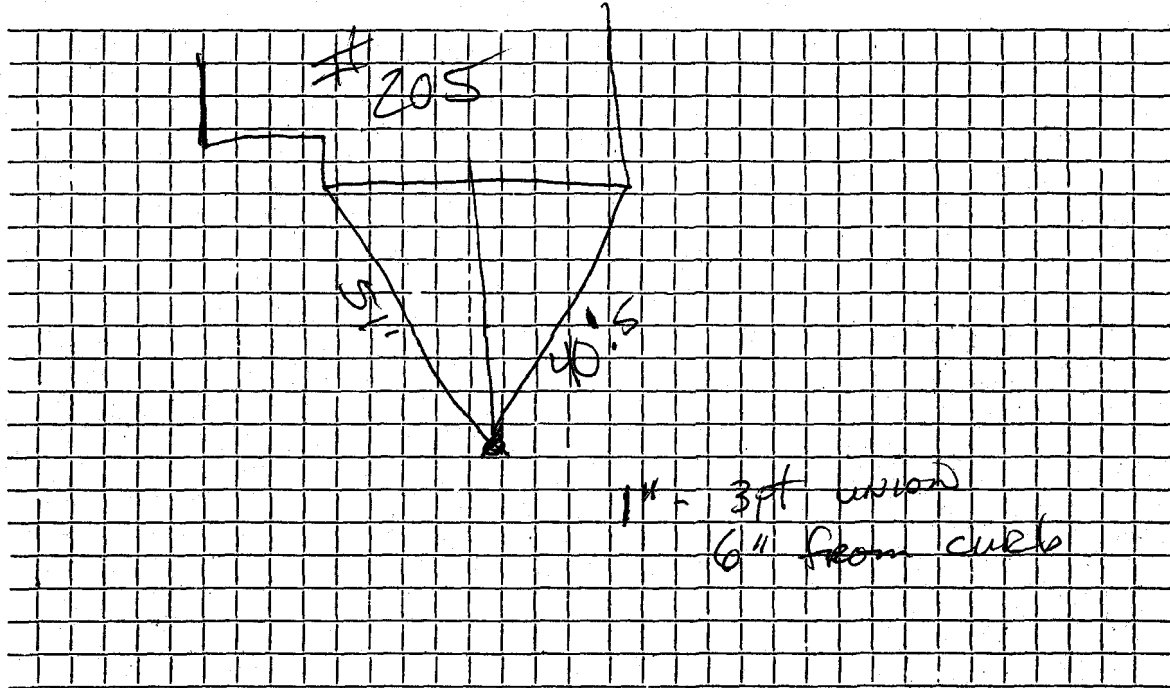

Connection made in ..... Street. Work completed .....

Remarks: ..... 2-28-01 ..... New house put up ..... old one torn down .....