

WATER SERVICE RECORD

2278

Service No. 141

Name Donald Miller

Address 207 Wood Street

#7240

Location Craftsman Inc. - Permit #163

~~Report~~ - New Service W.O. #9373


FEB 15 1965

Date	Material	Amount	Total	Date	Amount
8/23/60	outside 20'-1" Copper			11-19-64	Deposit 125 00
	1" CORP			3-2-65	Paid 20 49
	1" Curb				145 49
	1" x 3/4" Union				
					CURB TO MAIN
				12-10-64	Labor 79.47
					10% O.H. 7.95
					87 42
				25	3/4" Copper tubing @ .42 10 50
				1	3/4" Corp. Cock 7 41
				1	3/4" Curb Cock 8 76
				1	Box & Rod 4 90
					12 x 3 Patch 12 00
				1	Hr. Town Shovel @ 6.50 6 50
				1	Hr. Compressor @ 5.00 5 00
				1	Hr. Town Truck @ 3.00 3 00
					183 42
12-15-64	35' 3/4" Copper tubing				
					Bill sent 20 49

DATE _____

TOWN OF LEXINGTON — BOARD OF PUBLIC WORKS
WATER DIVISION

Sketch of Service Here

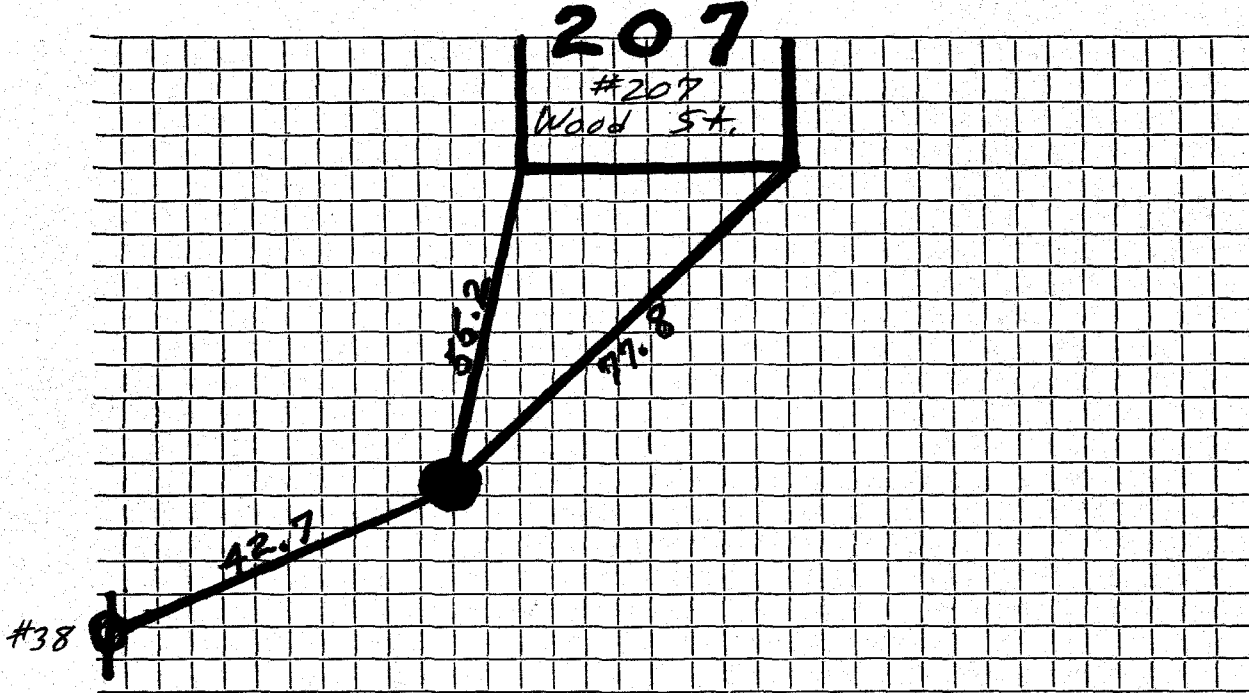

Connection made in Street. Work completed

Remarks:

.....

.....