

Name **McLaughlin Realty Trust**

Service No. **276** #2381

Address **221 Wood Street**

Lexington, Mass.

Location **221 Wood Street**

Kind of Pipe

Size

Size of Main

~~Repair~~ ~~Renewal~~ **New Service**

Com. **11-6-50**

Location

Date	Material	Amount	Total	Date	Amount
Sept. 6, '50	Labor	1 50	1 50	Aug 29 '50	30 00
	10% Overhead		15	Dec. 16 '50	1 07
	45' - 3/4" Copper Tubing @.275		12 38		81 07
	1 - 3/4" C x 1/2" I.W.H. S&W		3 29		No Charge
	Trucking 1 hr. @.75		75	Sept. 6, '50	Labor
	Patching 13 x 3		13 00	15'	3/4" Copper Tubing @.275
			31 07	1 - 3/4" C x 3/4" C	curb-cock
				1 - 3/4" C	Corp-cock
				1 - Box & Rod	
				1 - 1/2" Straight Tail Piece	
				1 - 1/2" Offset Tail Piece	
				Littlefield Shovel 2 hrs. @7.00	14 00
				Trucking 1 hr. @.75	75
	Labor			8/23/90	12' - 1" COPPER
					1" - COPP
					1" - Curb
					1/2 3/4 Union

Hadley Press, Inc., Lexington

DATE _____

TOWN OF LEXINGTON—BOARD OF PUBLIC WORKS

WATER DIVISION

The undersigned applies for a supply of water at No. _____ St. and hereby agrees to comply with the rules and regulations as now, or at any future time, established by the Board of Selectmen.

Am't. of Estimate \$ _____


Owner _____

Am't. Paid \$ _____

Address _____

Builder _____

Sketch of Service Here

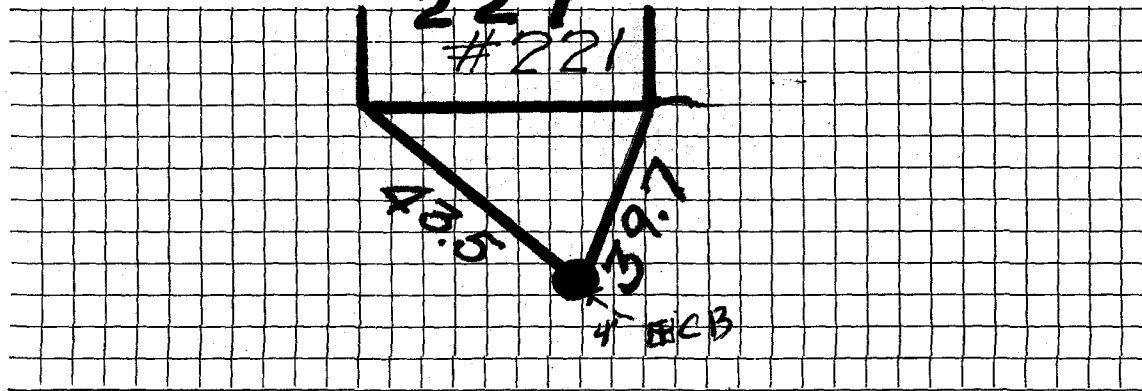

Connection made in _____ Street.

Work completed _____ 19

Remarks: