

Name McLaughlin Realty Trust

Service No. 276

Address 227 Wood Street

# 4649

Lexington, Mass.

Location 227 Wood Street

# 7111

# 7650

Kind of Pipe

Size

Size of Main

~~Repair~~ New Service

Com. 11-6-50

Location

Date	Material	Amount	Total	Date	Amount
Sept. 6, '50	Labor	1 50	1 50	Aug 29 '50	30 00
	10% Overhead		15	Dec 16 '50	7 27
	53' - 3/4" Copper Tubing @.275		14 58		37 27
	1 - 3/4" C x 1/2" I.W.H.S&W		3 29		No Charge
	Trucking 1 hr. @.75		75	Sept. 6, '50	Labor 9 13
	Patching 17 x 3		17 00	<del>19' - 3/4" Copper Tubing @.275</del>	<del>5 23</del>
			37 27	<del>1 - 3/4" C Corp cock</del>	<del>3 15</del>
				<del>1 - 3/4" C x 3/4" C Gurb cock</del>	<del>3 85</del>
				1 - 1/2" Straight Tail Piece	42
				1 - 1/2" Offset Tail Piece	42
				Littlefield Shovel 2 hrs. @7.00	14 00
				Trucking 1 hr. @.75	75
					40 30
	Labor			8/23/90	11' - 1" COPPER
					1" CORP
					1" Gurb
					1" x 3/4 Union

Hadley Press, Inc., Lexington

DATE \_\_\_\_\_

# TOWN OF LEXINGTON—BOARD OF PUBLIC WORKS

## WATER DIVISION

The undersigned applies for a supply of water at No. \_\_\_\_\_ St. and hereby agrees to comply with the rules and regulations as now, or at any future time, established by the Board of Selectmen.

Am't. of Estimate \$ \_\_\_\_\_


Owner \_\_\_\_\_

Am't. Paid \$ \_\_\_\_\_

Address \_\_\_\_\_

Builder \_\_\_\_\_

Sketch of Service Here

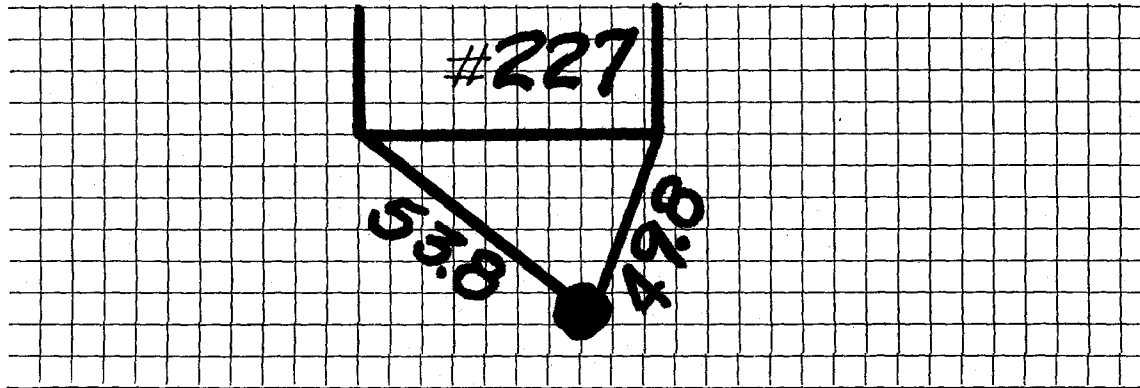

Connection made in \_\_\_\_\_ Street.

Work completed \_\_\_\_\_ 19

Remarks: