

Name McLaughlin Realty Trust

Service No. 276

Address 237 Wood Street

# 6419

Lexington, Mass.

Location 237 Wood Street

# 7804

Kind of Pipe

Size

Size of Main

~~Repair & Renewal~~ - New Service

Com. 11-6-50

Location

Date	Material	Amount	Total	Date	Amount
Sept. 5, '50	Labor	1 50	1 50	Aug 29 '50	30 00
	10% Overhead		15	Dec 16 '50	10 24
	42' - 3/4" Copper Tubing @.275		11 55		50 24
	1 - 3/4" C x 1/2" I.W.H. S&W		3 29		No Charge
	Trucking 1 hr. @.75		75	Sept. 5, '50	Labor
	Patching 23 x 3		23 00		20 65
			40 24		26' - 3/4" Copper Tubing @.275
					7 15
					1 - 3/4" C Corp cock
					3 15
					1 - 3/4" C x 3/4" C Curb-cock
					3 85
					1 - Box & Rod
					3 35
					1 - 1/2" Offset Tail Piece
					42
					1 - 1/2" Straight Tail Piece
					42
					Littlefield Shovel 2 hrs. @7.00
					14 00
					Trucking 1 hr. @.75
					75
	Labor			9/4/50	25' - 1" COPPER
					53 74
					1" CORP
					1" Curb
					1 x 3/4" Union

DATE \_\_\_\_\_

# TOWN OF LEXINGTON—BOARD OF PUBLIC WORKS

## WATER DIVISION

The undersigned applies for a supply of water at No. \_\_\_\_\_ St. and hereby agrees to comply with the rules and regulations as now, or at any future time, established by the Board of Selectmen.

Am't. of Estimate \$ \_\_\_\_\_


Owner \_\_\_\_\_

Am't. Paid \$ \_\_\_\_\_

Address \_\_\_\_\_

Builder \_\_\_\_\_

Sketch of Service Here

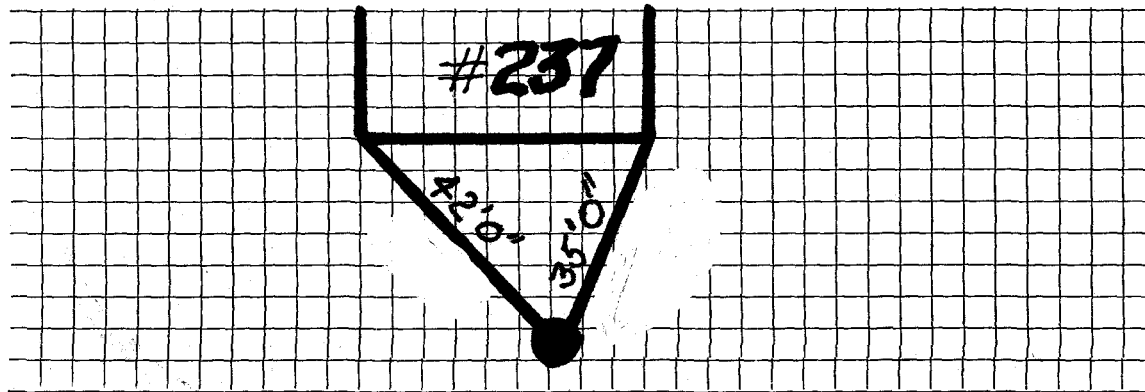

Connection made in \_\_\_\_\_ Street.

Work completed \_\_\_\_\_ 19

Remarks: