

Name Meade Inc.

Service No. 33

Address 253 Wood Street

Lexington, Mass. Location 253 Wood Street

Kind of Pipe

Size

Size of Main

Repair ~~Repair~~ - New Service

Com. 4-17-50

Location

Date	Material	Amount	Total	Date	Amount
Mar. 21 '50	Labor	4 05		March 22 '50	22 00
	10% Overhead	41	4 46	April 20 '50	00
	1- 3/4" C x 1/2" I.W.H. S & W		3 29		21 50
	1 hr. Trucking		75		
	Patching 13 x 3		13 00	Mar. 21 '50	41 00
			21 50		
					2 99
					3 15
					3 85
	Trench dug by owner;				3 70
	Ripe supplied & laid by owner				2 80
9/4/90	OUT				38
	18' - 1" COPPER				38
	Labor 1" CORP				6 00
	1" CURB				3 00
	1 x 3/4 Union				75
					68 00

March 22 '50 Defuncted
April 20 '50 Refunded

Non-Charge

~~18' - 3/4" Copper @~~
~~18' - 3/4" Tubing 23'~~

~~1 - 3/4" C. Corp cock~~

~~1 - 3/4" C x 3/4" C curb~~
~~cock~~

9/4/90

OUT
18' - 1" COPPER
Labor 1" CORP
1" CURB
1 x 3/4 Union

DATE _____

TOWN OF LEXINGTON - BOARD OF PUBLIC WORKS

WATER DIVISION

The undersigned applies for a supply of water at No..... St. and hereby agrees to comply with the rules and regulations as now, or at any future time, established by the Board of Selectmen.

Am't of Estimate \$.....

Owner


Am't Paid \$.....

Address

Builder

.....

Sketch of Service Here

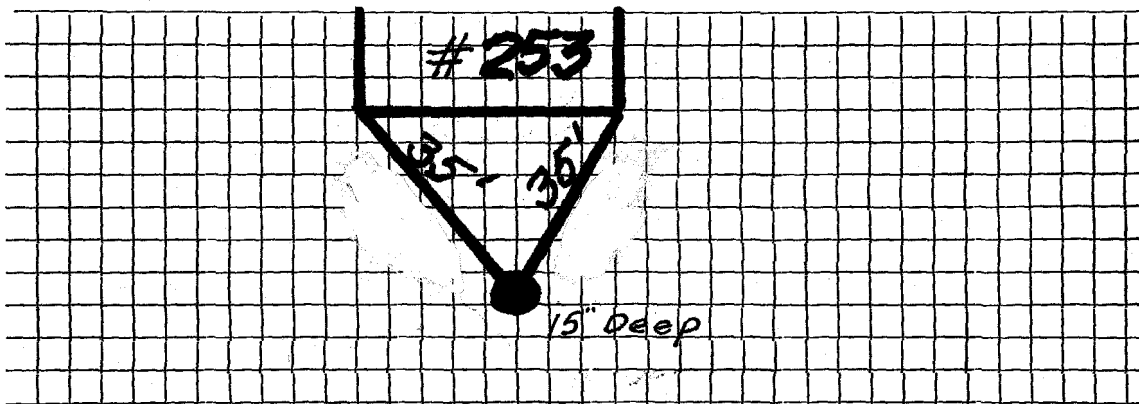

Connection made in Street.

Work completed19

Remarks: