

Name ~~Moade~~ Incorporated

Service No. 33

Address 259 Wood Street

Lexington, Mass.

Location 259 Wood Street

6749
6750

Kind of Pipe

Size

Cm. 5/22/50

Size of Main

~~Repair-Removal~~ New Service

Pipe supplied and laid by owner

Location

Date	Material	Amount	Total	Date	Amount
Apr. 3, '50	Labor	1 40	1 40	Mar 22 '50	18 00
	10% Overhead		14	Apr 25 '50	1 42
	1 - 3/4" C x 1/2" I.W.H. S&W		3 29		16 58
	Trucking 1 hr. @ .75		75	Apr. 3, '50	4 55
	Patching 11 x 3		11 00	18' - 3/4" Copper Tubing @ .23	4 14
			16 58	1 - 3/4" C Corp cock	3 15
				1 - 3/4" C x 3/4" C Curb-cock	3 85
				1 - Box & Rod	3 70
				1 - 1/2" Straight Tail Piece	38
				1 - 1/2" Offset Tail Piece	38
				Littlefield Shovel 2 1/2 hrs. @ 7.00	17 50
				Trucking 1 hr. @ .75	75
	Labor			9/5/90	38 40
				20' - 1" COPPER	
				1" CORP	
				1" CURB	
				1" x 3/4 Union	

TOWN OF LEXINGTON - BOARD OF PUBLIC WORKS

WATER DIVISION

The undersigned applies for a supply of water at No..... St. and hereby agrees to comply with the rules and regulations as now, or at any future time, established by the Board of Selectmen.

Am't of Estimate \$.....

Owner


Am't Paid \$.....

Address

Builder

.....

Sketch of Service Here

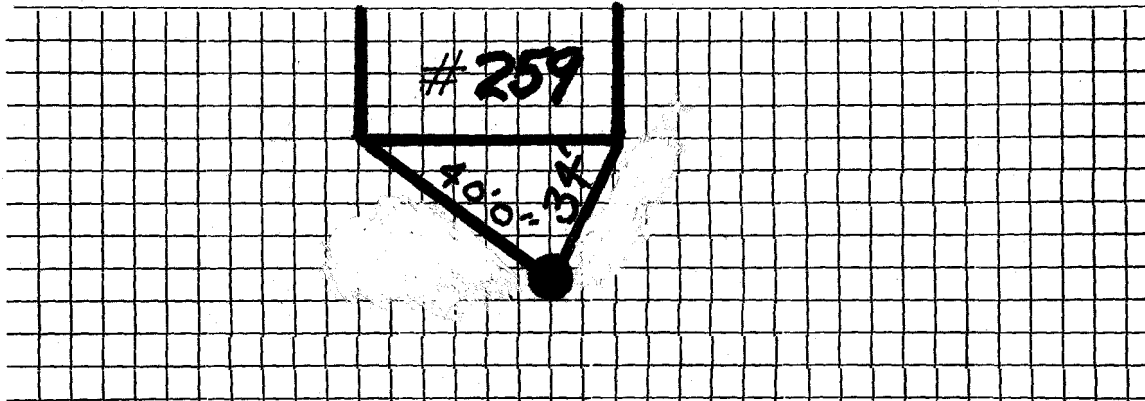

Connection made in Street.

Work completed19

Remarks: