

Name ~~Wade~~ Incorporated

# 3448

Service No. 33

Address 263 Wood Street

Lexington, Mass.

Location 263 Wood Street

Kind of Pipe

Size

*Com. 5/2/50*

Size of Main

~~Renewal~~—New Service Pipe supplied and laid by owner

Location

Date	Material	Amount	Total	Date	Amount
Apr. 3, '50	Labor	1 40	1 40	<i>Mar 22 '50</i>	<i>Deposited</i>
	10% Overhead		14	<i>May 25 '50</i>	<i>Refunded</i>
	1 - 3/4" C x 1/2" I.W.H. S&W		3 29		No Charge
	Trucking 1 hr. @ .75		75	Apr. 3, '50	Labor
	Patching 18 x 3		18 00	23' - 3/4" Copper Tubing @ .23	5 29
			23 58	<del>1 - 3/4" C Corp-cock</del>	3 15
				<del>1 - 3/4" C x 3/4" C Curb-cock</del>	3 85
				1 - Box & Rod	3 70
				1 - 1/2" Straight Tail Piece	38
				1 - 1/2" Offset Tail Piece	38
				Littlefield Shovel 2 hrs. @ 7.00	14 00
				Trucking 1 hr. @ .75	75
				<i>9/17/90</i>	<i>23' - 1" COPPER</i>
<i>3/21/98</i>	Labor REPLACED LEAKING CORP				<i>1" CORP</i>
	1" CORP				<i>1" Curb</i>
	1" UNION				<i>1" x 3/4" Union</i>
	1" COPPER				

DATE \_\_\_\_\_

# TOWN OF LEXINGTON - BOARD OF PUBLIC WORKS

## WATER DIVISION

The undersigned applies for a supply of water at No..... St. and hereby agrees to comply with the rules and regulations as now, or at any future time, established by the Board of Selectmen.

Am't of Estimate \$.....

Owner .....


Am't Paid \$.....

Address .....

Builder .....

.....

### Sketch of Service Here

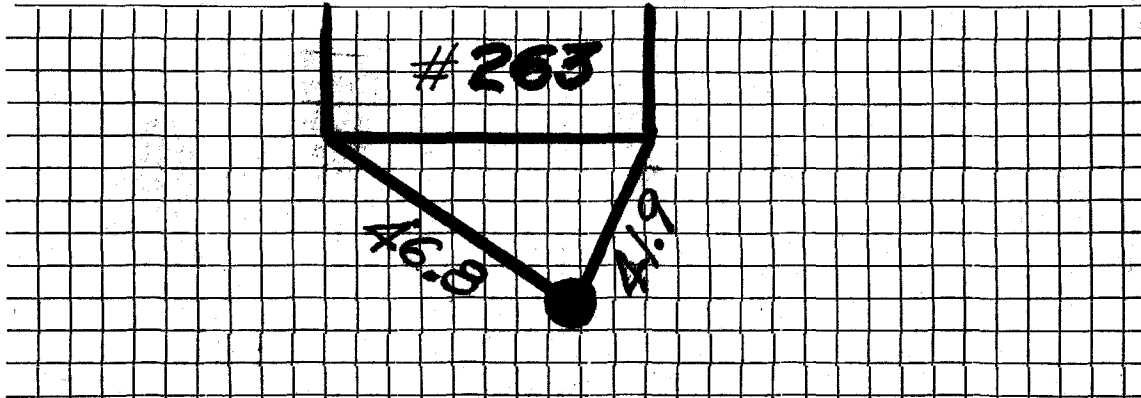

Connection made in ..... Street.

Work completed .....19

Remarks: