

#3587

Iris Larssen

WATER SERVICE RECORD

Name John T. Boyd

Service No. 148

Address 269 Wood Street

7528

Location

~~Reconnect~~ - New Service WO #7687


Comm 1-14-63

Date	Material	Amount	Total	Date	Amount
10-30-62	Labor	66.31		10-25-62	Deposit 300.00
	10% O.H.	6.03	66.34	1-14-63	Refund 32.05
	86' 3/4" Copper tubing @.42		36.12		167.95
	1 3/4" CX 1/2 I.W.H. Stop & Waste		6.17		
	2 3/4" C Corp Cock @4.91		9.82		NON CHARGE
	3 Hrs. Town Shovel @6.50		19.50	1030-62	Labor 25.95
	2 Hrs. Trucking @3.00		6.00		371 3/4" Copper tubing @.42 15.54
	24X3 Patch		24.00		1 3/4" C Corp Cock 4.91
			167.95		1 3/4" C Curb Cock 6.28
					1 Box & Rod 4.90
					1 1/2 Straight Tailpiece .50
					1 1/2 Offset Tailpiece .50
					1 Hr. Town Shovel @6.50 6.50
				9/17/90	27' - 1" COPPER 65.08
324-97	Repair made at comp.				1" CORP
	1" - Corp				1" Curb
	1" - 3pt unions				1" x 3/4 Union
	1' - 1" COPPER				

TOWN OF LEXINGTON — BOARD OF PUBLIC WORKS

WATER DIVISION

Sketch of Service Here

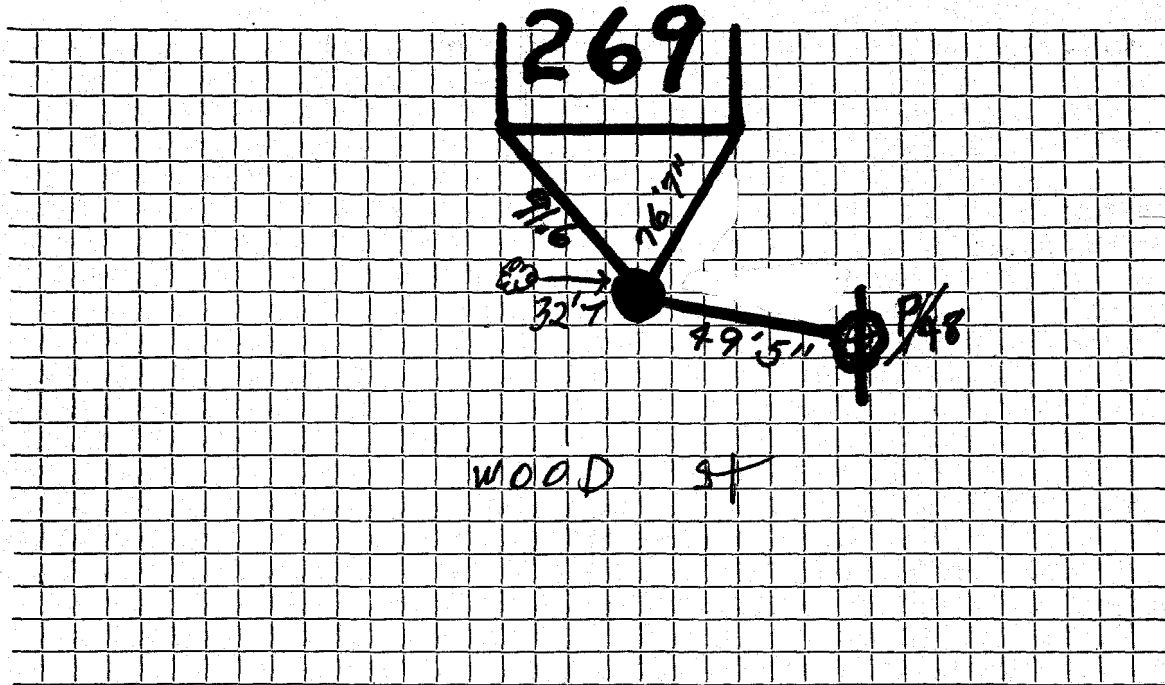

Connection made in Street. Work completed

Remarks:

.....

.....