

Name Priscilla A. Daudelin

Service No. ~~27~~ 3049

Address 7 Walnut Street, Newtonville, Massachusetts

2716

Location 275 Wood Street

Kind of Pipe

Size

Size of Main

Repair—Renewal—New Service

Location

Date 1939	Material	Amount	Total	Date	Amount
August 2,	16 hrs. @ 50¢	8 00		July 26, 1939	75 00
<i>Sum 9/11/39</i>	37 " @ 55¢	20 35		August 2, 1939	50 00
	25 " @ 60¢	15 00		September	125 00
	2 " @ 65¢	1 30		11, 1939	16 77
	6 " @ 70¢	4 20	48 85	Refunded	108 23
	10% Overhead		4 88	ADD	
	76' 1" Copper Tubing @ 30¢		22 80	1" - CORP	
	1 1" C/x I S.& W.		3 75	2' - 1" COPPER	
	1 1" C Union (3 part)		1 10	1" - Union	
	1 1" Bushing		10		
	4 hrs. trucking @ 75¢		3 00		
	Trench repairs		20 00		
			104 48		
	Const. charge		3 75		
	Labor		\$108 23		

Hadley Press, Inc., Lexington

TOWN OF LEXINGTON—BOARD OF PUBLIC WORKS
WATER DIVISION

The undersigned applies for a supply of water at No. 275 Wood St. and hereby agrees to comply with the rules and regulations as now, or at any future time, established by the Board of Selectmen.

Am't. of Estimate \$ _____

Owner

Priscilla A. Daudelin


Am't. Paid \$ _____

Address

2 Walnut St
Newtownville

Builder _____

Sketch of Service Here

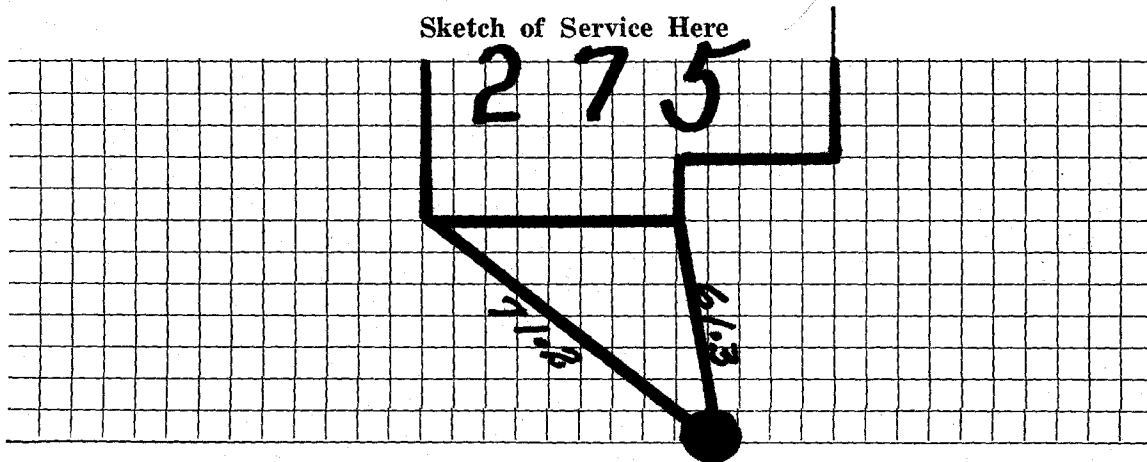

Connection made in _____ Street.

Work completed _____ 19

Remarks: