

WATER SERVICE RECORD

Name *Diamond West Realty*

Service No.

Address *#277 Wood St*

Location

~~Repair~~ ~~Removal~~ ~~New Service~~ *Redmond #3931*


| Date | Material | Amount | Total | Date | Material | Amount |
|----------------|-------------------------------|--------|-------|----------------|-----------------------------|--------|
| <i>12/8/84</i> | <i>75' x 1" Copper Tubing</i> | | | | | |
| | <i>1 1" x 3 Part Union</i> | | | | | |
| | <i>1 1" R.H. Wheel Valve</i> | | | | | |
| | | | | | <i>OUTSIDE</i> | |
| | | | | <i>12/8/84</i> | <i>34' 1" Copper Tubing</i> | |
| | | | | <i>9/5/90</i> | <i>1 1" Corp Cock</i> | |
| | | | | | <i>1 Box & Rod</i> | |
| | | | | | <i>2' - 1" COPPER</i> | |
| | | | | | <i>1" Union</i> | |

DATE DEC 1984

TOWN OF LEXINGTON — BOARD OF PUBLIC WORKS

WATER DIVISION

Sketch of Service Here

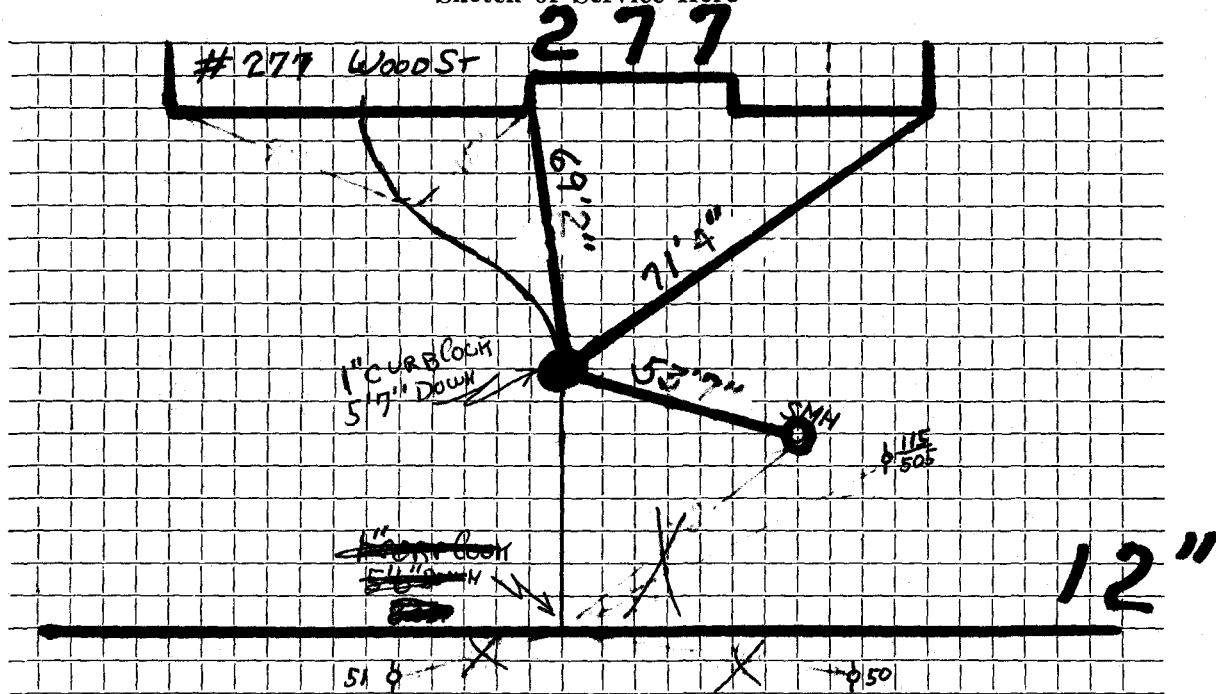

Connection made in WOOD ST Street. Work completed DEC 8, 1984

Remarks:

.....

.....