

Name Murray Roberts

Service No. ⁶⁸ 3305

Address 28 Wood Street

2409
2410

Lexington, Mass.

Location 28 Wood Street

Kind of Pipe

Size

Size of Main

~~Repair~~ ~~Renewal~~ New Service

Location

Date	Material	Amount	Total	Date	Amount
Jul. 23, '47	Labor	29 93	29 93	July 21 '47	60 00
	10% Overhead		2 99	Sept 15 '47	1 75
	55' - 3/4" Copper Tubing @.28		15 40		58 22
	1 - 3/4" C x 1/2" I.W.H. S & W		3 15	Jul. 23, '47	19 47
	Patching 6 x 3		6 00	24	10 96
	Trucking 1 hr. @.75		75		2 80
			58 22	10' - 3/4" Copper Tubing @.28	3 00
				1 - 3/4" C Corp-cock	3 68
				1 - 3/4" C x 3/4" C Curb-cock	4 26
				1 - Box & Rod	30
				1 - 1/8" Straight Tail Piece	30
				1 - 1/2" Offset Tail Piece	75
				Trucking 1 hr. @.75	45 52
	Labor			6/26/90	1" CORP
					1" CURB
					3/6" - 1" COPPER
					3/4 x 1" UNION

Hadley Press, Inc., Lexington

DATE _____

TOWN OF LEXINGTON—BOARD OF PUBLIC WORKS

WATER DIVISION

The undersigned applies for a supply of water at No. _____ St. and hereby agrees to comply with the rules and regulations as now, or at any future time, established by the Board of Selectmen.

Am't. of Estimate \$ _____

Owner _____


Am't. Paid \$ _____

Address _____

1437 Mass Avenue

Builder _____

Sketch of Service Here

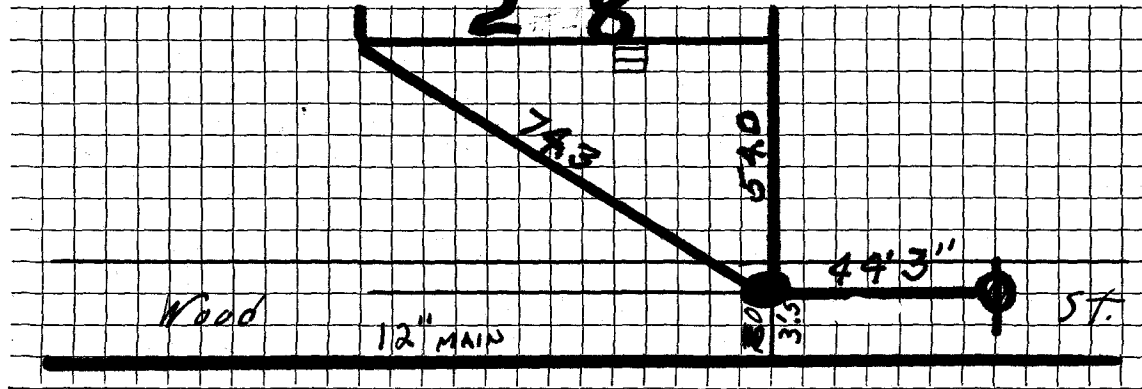

12"

Connection made in _____ Street.

Work completed _____ 19

Remarks: