

Name Hugh J. Maguire

Service No.

269

Address 290 Wood Street

Lexington, Mass.

Location

Kind of Pipe

Size

Size of Main

~~REPAIR WORK~~—New Service

Location

Date	Material	Amount	Total	Date	Amount
Nov. 8, '48	Labor	7 46	7 46	Nov. 9, '48 Deposited	50 00
	10% Overhead		75	Dec. 31 '48 Refunded	9 27
	60'-3/4" Copper Tubing @ .255	15 30		Non charge	40 23
	1-3/4" C x 1/2" I.W.H. S&W		3 15	Nov. 8, '48 Labor	7 47
	1-3/4" C x 3/4" C. Union (3 pts)	1 32		0'-3/4" Copper Tubing @ .255	2 30
	1 hr. Littlefield Shovel		7 00	1-3/4" C. Corp-cock	3 00
	1 hr. Trucking		75	1-3/4" C x 3/4" G. Curb-cock	3 68
	Patching 5 x 3	5 00	5 00	1-Box & Rod	3 55
			40 73	1-1/2" Offset Tail Piece	30
				1-1/2" Straight Tail Piece	30
				1 hr. Littlefield Shovel	7 00
				1 hr. Trucking	75
	Labor			9/17/90 9' - 1" COPPER	28 35
				1" - CORP	
				1" - Curb	
				1 1/2 3/4 Union	

DATE \_\_\_\_\_

TOWN OF LEXINGTON - BOARD OF PUBLIC WORKS

**WATER DIVISION**

The undersigned applies for a supply of water at No..... St. and hereby agrees to comply with the rules and regulations as now, or at any future time, established by the Board of Selectmen.

Am't of Estimate \$.....

Owner .....


Am't Paid \$.....

Address .....

Builder .....

.....

Sketch of Service Here

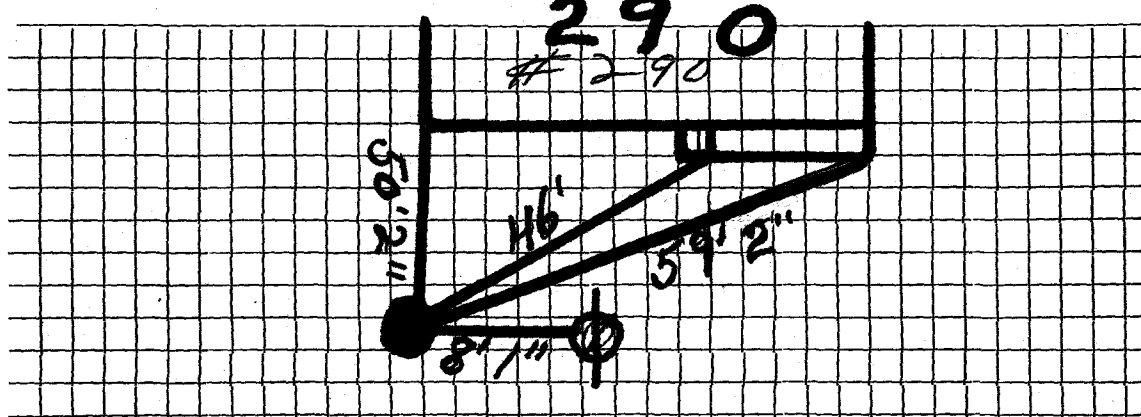

Connection made in ..... Street.

Work completed .....19

Remarks: