

WATER SERVICE RECORD

#248
35

Name R. H. Hersom

Service No.

Address 291 Wood Street

Location Lexington

~~Repair/Replacement~~ - New Service

COM. 4-28-52


Date	Material	Amount	Total	Date	Amount
3/24/52	Labor	15 00	15 00	3-17-52	Deposited 100 00
	10% overhead		1 50	4-28-52	Re-funded (13 84)
	82' - 3/4" copper tubing @ .3439		28 19		NON CHARGE 86 16
	1 - 3/4" C x 1/2 I.W.H. stop & waste		4 00	3/24/52	Labor 16 56
	1 - 3/4" C x 3/4" C. union		1 72	30' - 3/4" copper tubing @ .3439	10 32
	3 hrs. town shovel @ 5.00		15 00	1 - 3/4" C. corp-cock	4 33
	1 hr. trucking		75	1 - 3/4" C x 3/4" C. curb-cock	4 67
	patching 20 x 3		20 00	1 box and rod	4 52
			86 16	1 - 1/2 offset tail piece	50
				1 - 1/2 straight tail piece	50
				2 hrs. town shovel	10 00
				1 hr. trucking	75
				9/18/90	31' - 1" COPPER 52 15
					1" CORP
					1" Curb
					1" x 3/4 Union

DATE _____

TOWN OF LEXINGTON — BOARD OF PUBLIC WORKS

WATER DIVISION

Sketch of Service Here

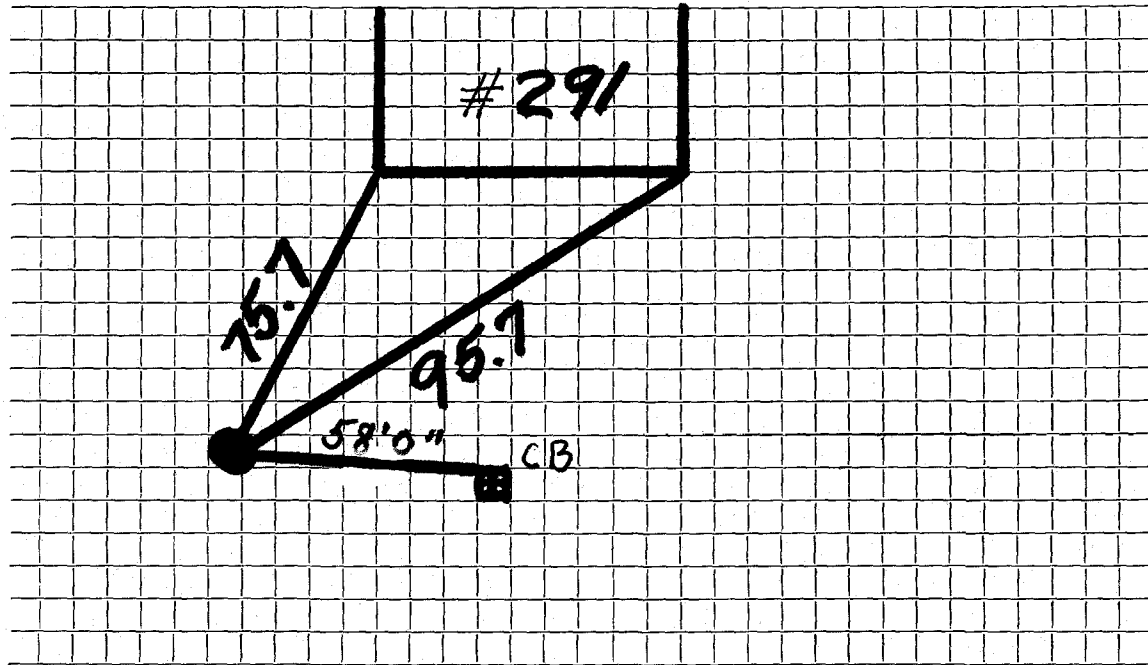

Connection made in Street. Work completed

Remarks:

.....

.....