

Name Worth Coombs

Service No. 33 3097

Address 34 Wood Street

#6123

Lexington, Mass.

Location 34 Wood Street

Kind of Pipe

Size

Size of Main

Repair—Renewal—New Service

Location

Date	Material	Amount	Total	Date	Amount	
Dec. 8, '45	Labor	90	90	Nov 19 '45	35 00	
	10% Overhead		09	Dec 20 '45	18 49	
	62' - 3/4" Copper Tubing		11 85		21 51	
	1 - 3/4" C x 3/4" I.W.H. Stop & Wst.	2	59	12-8-45	Labor	10 40
	1 - 3/4" x 1/2" Bushing		29	12-1-45	3/4" Copper Tubing	2 29
	1 - 3/4" C. Union (3 parts)		1 04	1 - 3/4" C. Corp-cock	3 02	
	Trucking 1 hr. @ .75		75	1 - 3/4" C x 3/4" C. curb-cock	3 02	
	Patching 6' x 3'		4 00	1 - Box & Rod	1 65	
			21 51	1 - 1/2" Offset Tail Piece	36	
				1 - 1/2" Straight Tail Piece	36	
				Trucking 1 hr.	75	
				Compressor 1 hr.	1 75	
	Labor			7/2/90	14'- 1" COPPER	23 60
					1" CORP	
					1" CURB	
					1" X 3/4 UNION	

Hadley Press, Inc., Lexington

DATE _____

TOWN OF LEXINGTON—BOARD OF PUBLIC WORKS

WATER DIVISION

The undersigned applies for a supply of water at No. _____ St. and hereby agrees to comply with the rules and regulations as now, or at any future time, established by the Board of Selectmen.

Am't. of Estimate \$ _____


Owner _____

Am't. Paid \$ _____

Address _____

Builder _____

Sketch of Service Here

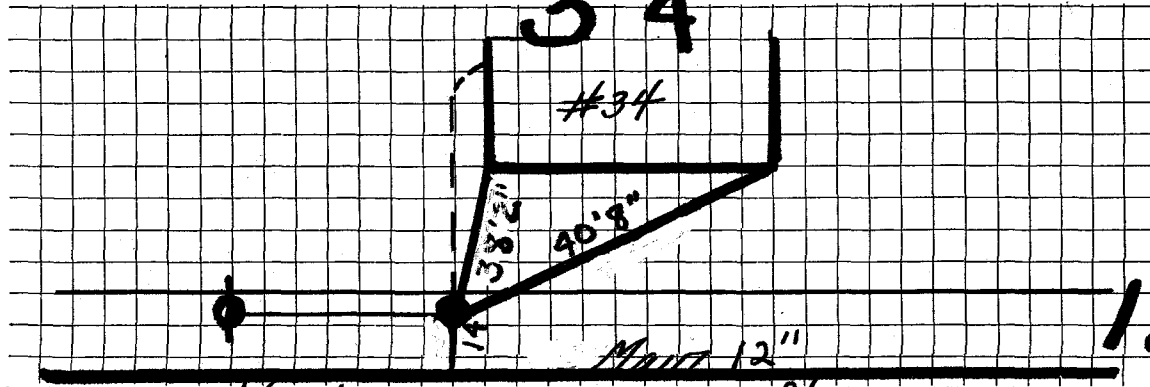

Connection made in Wood Street.

Work completed 12" 19

Remarks: