

WATER SERVICE RECORD

Name

Service No.

Address

Location 39 Wood Street

Repair—Renewal—New Service


Date	Material	Amount	Total	Date	Amount
6-13-'47	53' $\frac{3}{4}$ " Copper				
	1 $\frac{3}{4}$ " C. X $\frac{1}{2}$ " I. W. H. Stop + Waste			7-5-90	
	1 $\frac{3}{4}$ " C. X $\frac{3}{4}$ " C. 3 Part Union				
				25' 1" Copper	
				1 1" Corp Cock	
				1 1" Curb Cock	
				1 1" X $\frac{3}{4}$ " Union	

DATE \_\_\_\_\_

TOWN OF LEXINGTON — BOARD OF PUBLIC WORKS

**WATER DIVISION**

Sketch of Service Here

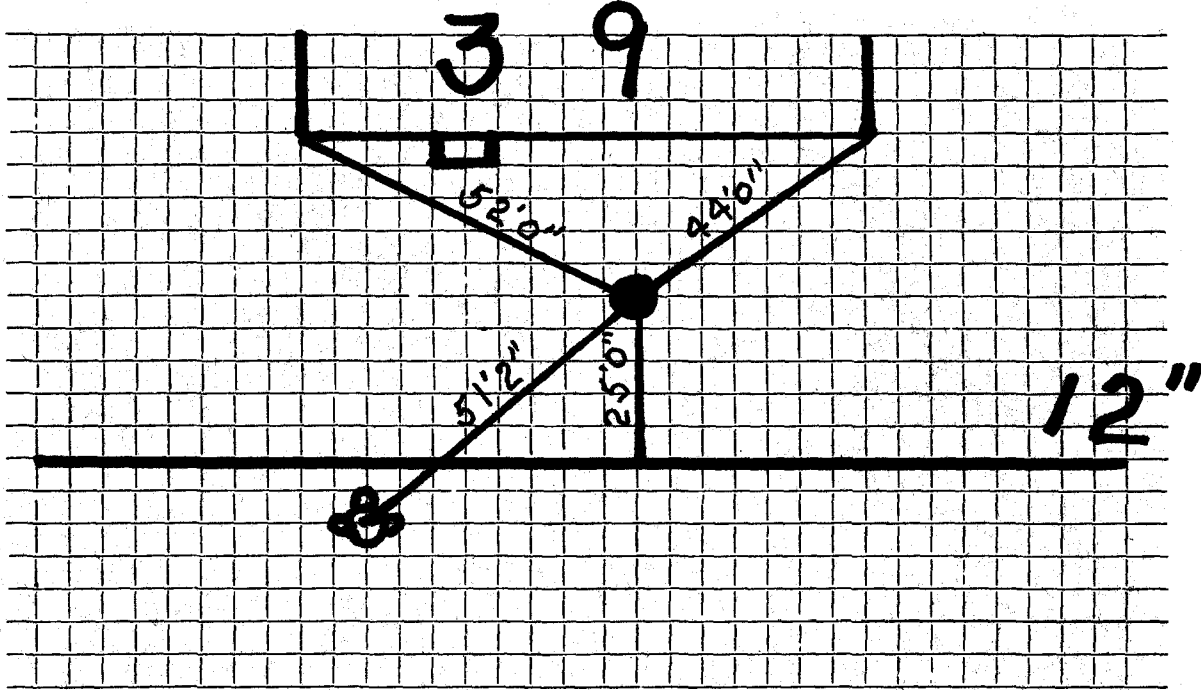

Connection made in ..... Street. Work completed .....

Remarks: .....  
.....  
.....