

WATER SERVICE RECORD

Name H.A. McLaughlin

Service No. 259

Address 40 Wood Street, Lexington

Location Mail: 28 Grozier Road, Cambridge, Mass.

~~Repair~~ ~~Renewal~~ New Service

Com. 11-21-55


Date	Material	Amount	Total	Date	Amount
8/26/55	Labor	7 35		8-15-55 Deposited	50 00
	10% Overhead	74	8 09	12-7-55 Paid	10 96
	55'-3/4" Copper tubing @.384		21 12		60 96
	1-3/4" Cx 1/2" I.W.H. stop & waste		4 00	8/26/55 Labor	1 85
	12 x 3 Patch		12 00	<del>1-3/4" Copper tubing @.384</del>	5 38
	1 hr. trucking @.75		75	1-3/4" C. Corp Cock	4 33
	2 hrs. Littlefield Shovel @7.50		15 00	1-3/4" Cx 3/4" C. Curb Cock	4 67
			60 96	1 Box & Rod	3 90
				1-1/2" straight tail piece	50
				1-1/2" offset tail piece	50
				1 hr. trucking @.75	75
				7/2/90 1 1/2" - 1" COPPER	21 88
				1" - CORP	
				1" - CURB	
				1" x 3/4 Union	
				Bill sent 11-22-55	

DATE \_\_\_\_\_

TOWN OF LEXINGTON — BOARD OF PUBLIC WORKS

WATER DIVISION

Sketch of Service Here

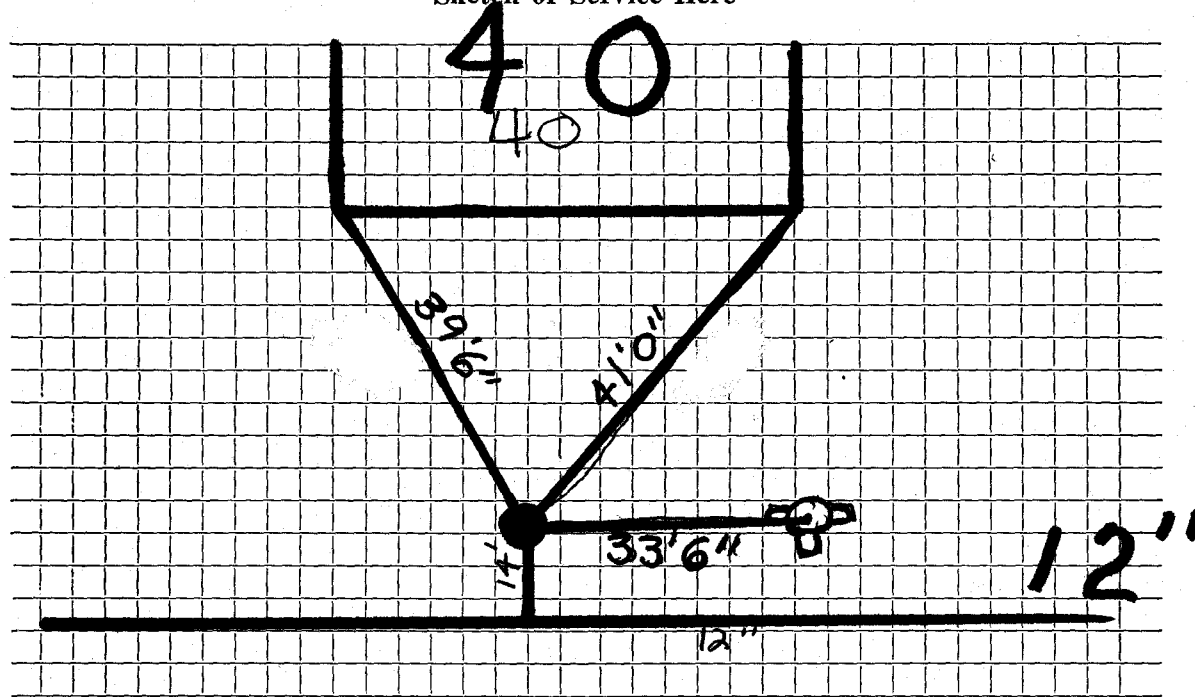

Connection made in ..... Street. Work completed .....

Remarks: .....  
.....  
.....