

WATER SERVICE RECORD

Name Joseph J. Napoli

Service No. 142

Address 43 Wood Street

#7713

Location

~~Repair~~ ~~Work~~ New Service

Comm 11-17-58


Date	Material	Amount	Total	Date	Amount
7/29/58	Labor	26 65		7-21-58	100 00
	10% Overhead	2 67		12-8-58	1 32
		29 32	29 32		101 32
	72' 3/4" Copper tubing @ .37	26 64			
	1 3/4" Cx 1/2 I.W.H. Stop & Waste				NON CHARGE
			5 84	7/28/58	Labor
	1 3/4" C3 part Union	2 27			36' 3/4" copper tubing
	1 1/2 hr. town shovel @ 6.50	9 75			@ .37
	2 hrs. trucking @ .75	1 50			1 3/4" G. Corp Cock
	1 hr. Rogers trailer @ 3.00	3 00			1 3/4" G Curb Cock
	1 hr. trucking @ 3.00	3 00			1 Box & Rod
	20 x 3 Patch	20 00			1 1/2 straight tail Piece
			101 32		1 1/2 Offset tail piece
				7/15/60	1/2 hr. town shovel @ 6.50
					31'-1" COPPER
					1" - CORP
					1" - Curb
					1 1/2" x 3/4" Union

DATE _____

TOWN OF LEXINGTON — BOARD OF PUBLIC WORKS

WATER DIVISION

Sketch of Service Here

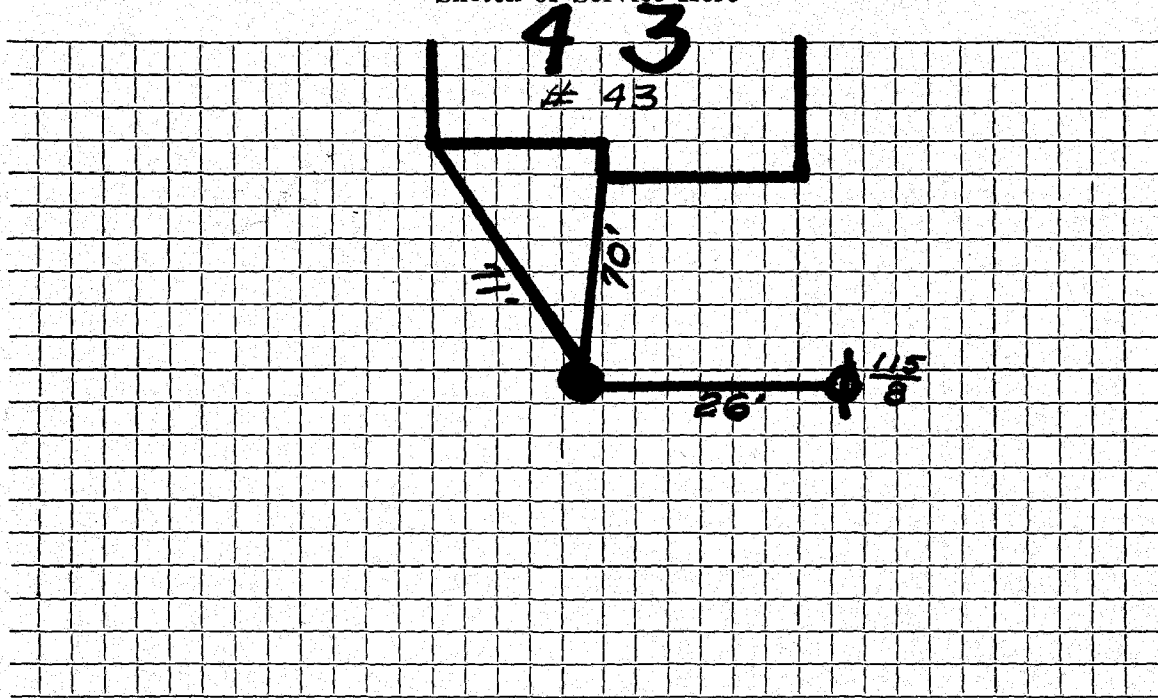

Connection made in Street. Work completed

Remarks:

.....

.....