

Name Joseph Napoli

Service No.

28

Address 47 Wood Street

4081

Lexington, Mass.

Location 47 Wood Street

Kind of Pipe

Size

Size of Main

Register Request - New Service Com. 5-2-49

Location

Date	Material	Amount	Total	Date	Amount
March 23, '49	Labor	4 35	4 35	March 16 '49	60 00
	10% Overhead		44	May 5 '49	7 25
	46' - 3/4" Copper Tubing @.27	12 42			52 25
	1 - 3/4" C x 1/2" I.W.H. S & W	3 29			Non-Charge
	Littlefield Shovel 2 hrs. @7.00	14 00		March 23, '49	Labor
	Trucking 1 hr. @.75	75			24' - 3/4" Copper Tubing @.27
	Patching 17 x 3	17 00			1 - 3/4" C Corp-cock
			52 25		1 - 3/4" C x 3/4" C Curb-cock
					1 - Box & Rod
					1 - 1/2" Offset Tail Piece
					1 - 1/2" Straight Tail Piece
					Littlefield Shovel 2 hrs. @7.00
					Trucking 1 hr. @.75
	' Labor			7/11/90	37 27
					33' - 1" COPPER
					1" - CORP
					1" - CURB
					1" x 3/4 UNION

DATE _____

TOWN OF LEXINGTON - BOARD OF PUBLIC WORKS

WATER DIVISION

The undersigned applies for a supply of water at No..... St. and hereby agrees to comply with the rules and regulations as now, or at any future time, established by the Board of Selectmen.

Am't of Estimate \$.....

Owner


Am't Paid \$.....

Address

Builder

.....

Sketch of Service Here

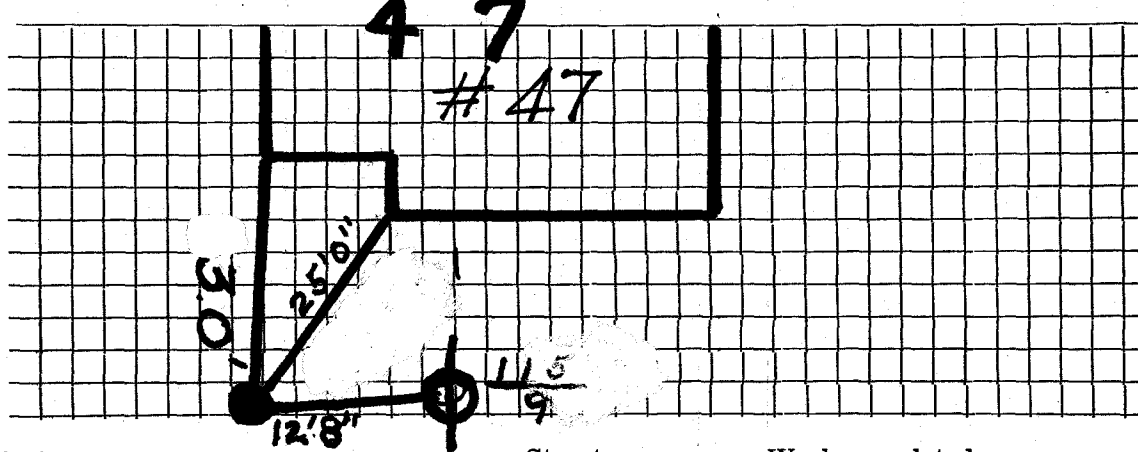

Connection made in Street.

Work completed19

Remarks: