

WATER SERVICE RECORD

Name Lexington Const. Co.

Service No. 231

Address 55 Wood St.

Location Lexington

~~REPAIR & REPLACE~~ - New Service

Com. 9-14-53

Date	Material	Amount	Total	Date	Amount
8/19/53	Labor	8 00		8-3-53	Deposited 75 00
	10% overhead	80	8 80	9-14-53	Refunded (5 33)
	70' - 3/4" Copper tubing @ .3629		25 40		NON CHARGE 69 67
	1-3/4" C x 1/2 I.W.H. STOP & WASTE	4 00		8/19/53	Labor 14 92
	1-3/4" C x 3/4" C. Union (3 parts) @ 1.72	5 16	1 72	22-3/4"	Copper Tubing @ .3629 7 98
	2 Hr. Littlefield Shovel @ 7.50	15 00		1-3/4" C. Corp-cock	4 33
	1 Hr. Trucking		75	1-3/4" C x 3/4" C. Curb-cock	4 67
	Patching 14 x 3		14 00	1-Box & Rod	3 90
			69 67	1-1/8 offset tail piece	50
				1-1/8 straight tail piece	50
				2 Hr. Littlefield Shovel @ 7.50	15 00
				1 Hr. Trucking	75
				7/11/90	32' - 1" COPPER 52 55
					1" CORP
					1" Curb
					1" x 3/4 Union


DATE _____

TOWN OF LEXINGTON — BOARD OF PUBLIC WORKS

WATER DIVISION

Sketch of Service Here

BEARING
TOP OF
SERVICE

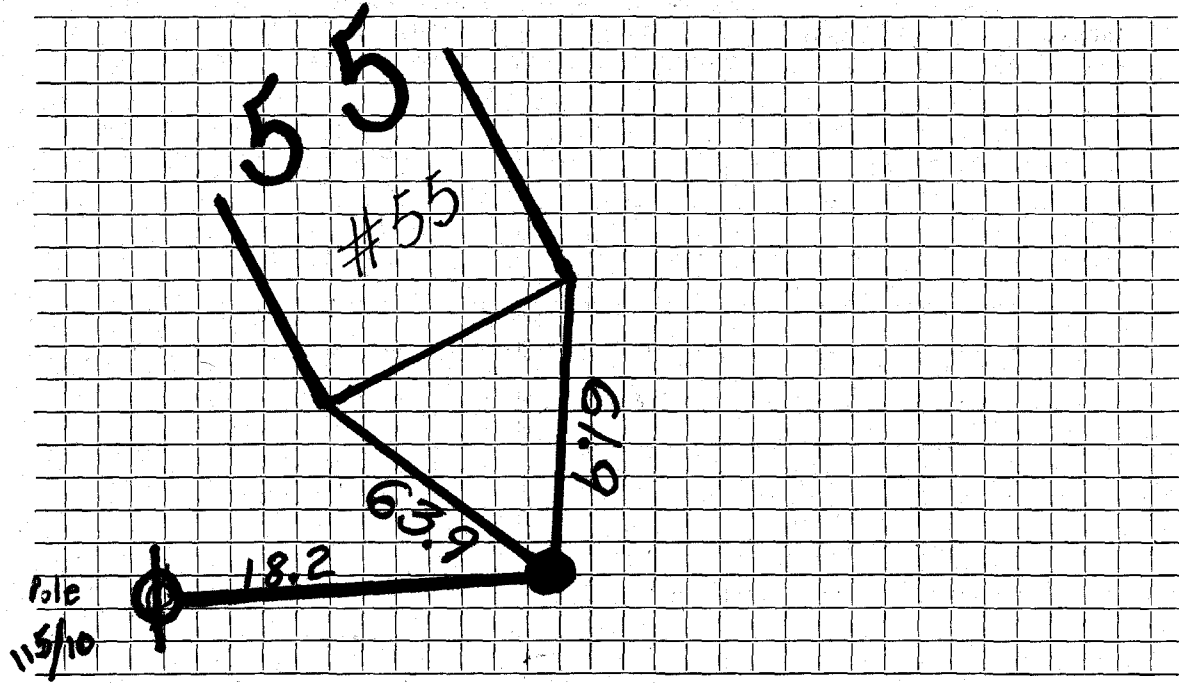

Connection made in Street. Work completed

Remarks:

.....

.....