

## WATER SERVICE RECORD

Name Philip Heidke

Service No. 20

Address 62 Wood Street

Location

~~Repair~~ ~~Renewal~~ New Service W.O. 5597

DEC 12 1977


Date	Material	Amount	Total	Date	Amount	
7/28/77	Labor	36 70		7-15-77	Deposit	148 00
	Police Duty	24 00		12-12-77	Retard	31 31
	10% O.H.	<del>60 78</del> 6 07	66 77			138 79
11'	1" Copper @ 1.08		11 88			
1	1" Corporation		16 69			
1	1" Curb		20 54			
1	Box & Rod		13 41			
11	Hr. Trucking		3 00			
1	Hr. Shovel		6 50			
8-4-77	45' 1" Copper tubing		138 79			
	25'					
7/3/90	1" CORP					
	2' - 1" COPPER					
	1" Union					

DATE \_\_\_\_\_

TOWN OF LEXINGTON — BOARD OF PUBLIC WORKS

WATER DIVISION

Sketch of Service Here

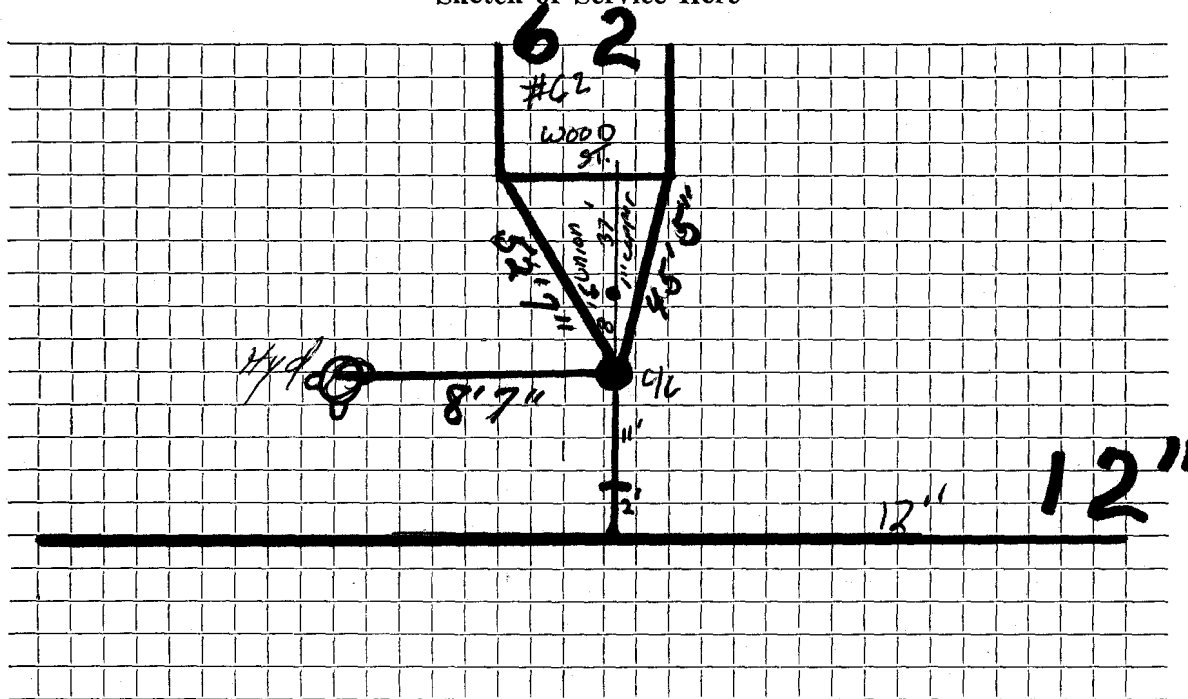

Connection made in ..... Street. Work completed .....

Remarks: .....  
.....  
.....