

## WATER SERVICE RECORD

Name Philip C. Heidke

Service No. 60

Address # 67 Wood Street

Location

~~Repair~~ New Service

W.O. #5032 Eagle #2883


MAY 9 1977

Date		Material	Amount	Total	Date	Amount
11/3	76	40' - 1" copper			11-26-76	Deposit 750 00
11-2-76		Labor	66.60		5-9-77	Retard 11 45
		10% O.H.	6.66	73.26		138 85
	17 1/2'	1" Copper tubing @ .83		14.53		
	1	1" Corp.		16.69		
	1	1" Curb		18.67		
	1	Box & Rod		15.40		
				138.55		
7/3/90		1" Corp				
		4' - 1" COPPER				
		1" UNION				

DATE \_\_\_\_\_

TOWN OF LEXINGTON — BOARD OF PUBLIC WORKS

WATER DIVISION

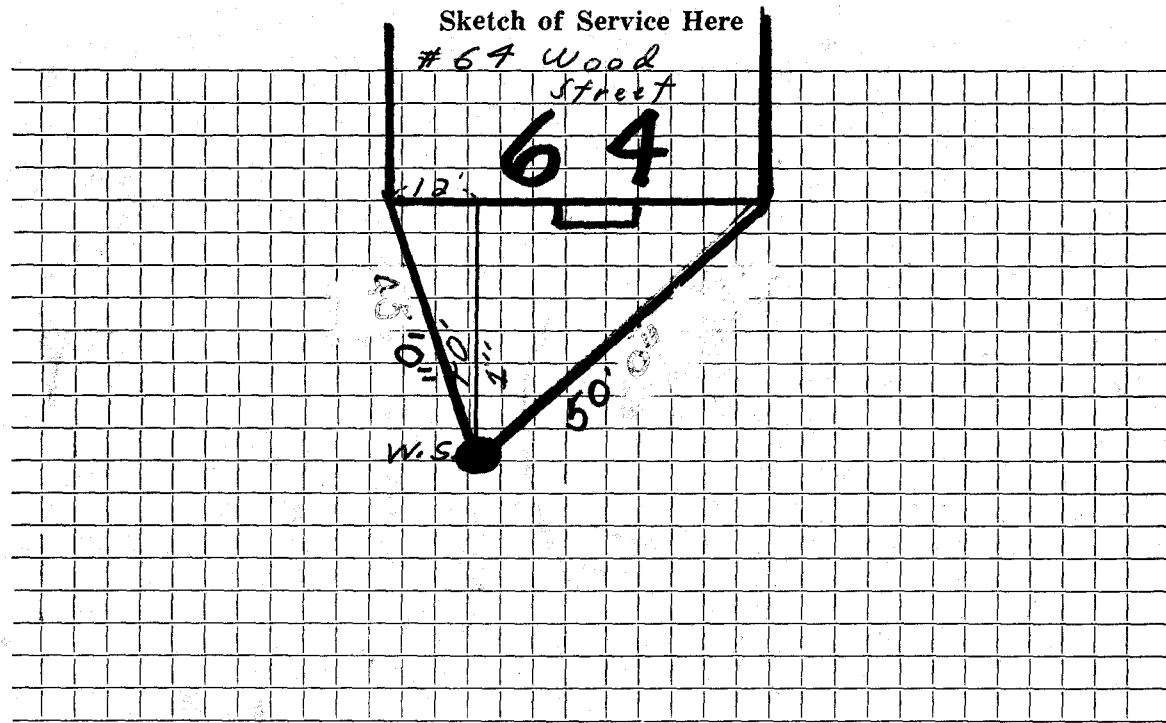

Connection made in Wood ..... Street.      Work completed .....

Remarks: .....  
.....  
.....