




DATE 8-14-01

TOWN OF LEXINGTON — BOARD OF PUBLIC WORKS

WATER DIVISION

Sketch of Service Here

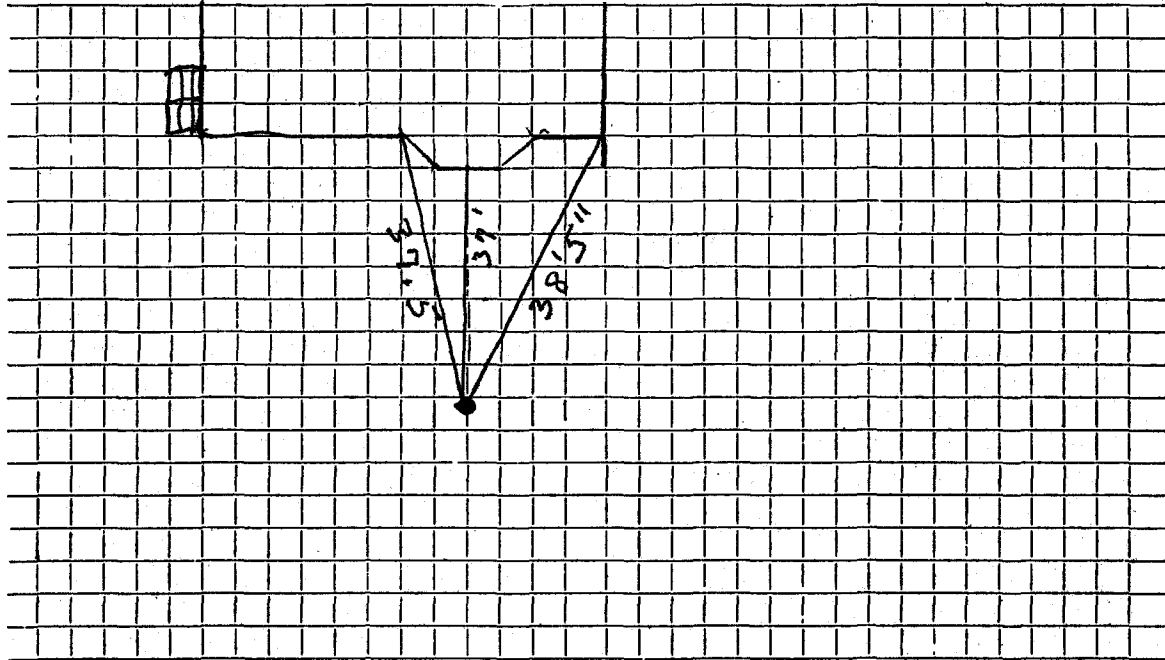

Connection made in ... wood ..... Street. Work completed ... 8-9-01 .....

Remarks: .....  
.....  
.....