

WATER SERVICE RECORD

Name Richard H. Soule

Service No. 28

Address 71 Wood Street

Location

~~Repair~~—New Service

Com. 3-22-54


Date	Material	Amount	Total	Date	Amount
3/3/54	Labor	6 25		2-19-54	Deposited 75 00
	10% overhead	63	6 88	3-22-54	Refunded 14 10
	60' - 3/4" copper tubing@.3629		21 77		<u>NON CHARGE</u> 60 90
	1 - 3/4" C x 1/2 I.W.H. stop & waste	4 00		3/3/54	Labor 8 00
	1 hr. Littlefield shovel		7 50		30' - 3/4" copper tubing@.3629 10 89
	patching 20 x 3		20 00		1 - 3/4" C. corp-cock 4 33
	1 hr. trucking		75		1 - 3/4" C x 3/4" C. curb-cock 4 67
			60 90		1 box and rod 3 90
					1 - 1/2 straight tail piece 50
					1 - 1/2 offset tail piece 50
					2 hrs. Littlefield shovel@ 7.50 15 00
					1 hr. trucking 75
					<u>48 54</u>
				7/9/90	31' - 1" COPPER
					1" CORP
					1" CURB
					1" x 3/4 Union

DATE _____

TOWN OF LEXINGTON — BOARD OF PUBLIC WORKS

WATER DIVISION

Sketch of Service Here

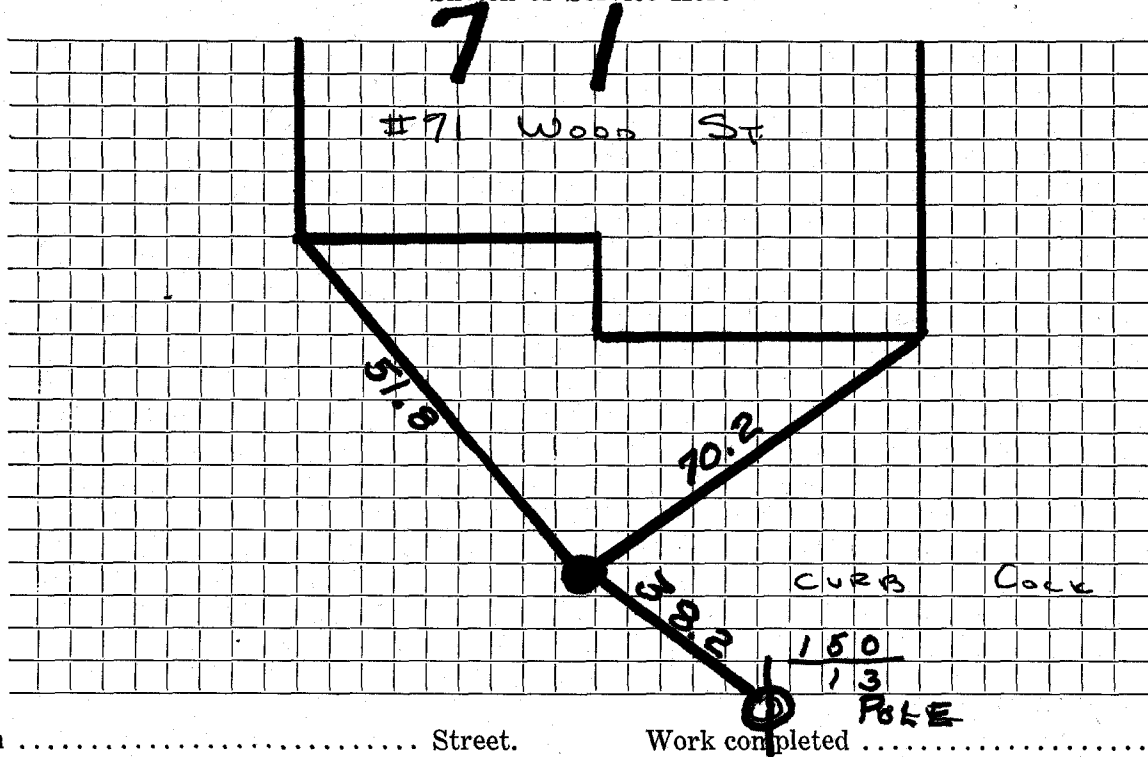

Connection made in Street. Work completed

Remarks:

.....

.....