

# WATER SERVICE RECORD

Name

Service No.

Address

Location **77 Wood Street**

Repair—Renewal—New Service


Date	Material	Amount	* Total *	Date	Amount
9-6-50	57' 3/4" Copper				
	1 3/4" C. X 1/2" I. W. H. Stop + Waste			7-9-90	
				14' 1" Copper	
				1 1" Corp Cock	
				1 1" Curb Cock	
				1 1" C. X 3/4" UNION	
				1 Box + Rod	

DATE \_\_\_\_\_

TOWN OF LEXINGTON — BOARD OF PUBLIC WORKS

WATER DIVISION

Sketch of Service Here

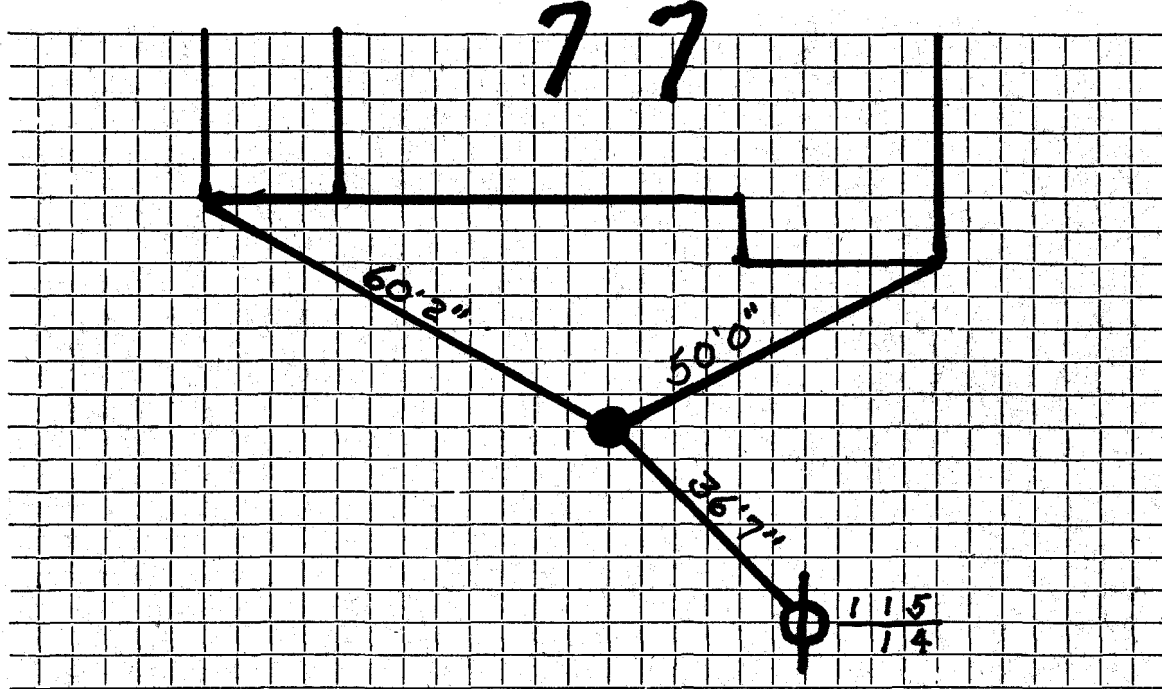

Connection made in ..... Street. Work completed .....

Remarks: .....

.....

.....