

WATER SERVICE RECORD

Name Philip Heidke

Service No. 15

Address 78 Wood Street

Location

~~Repair/Reconnect~~ - New Service W.O. #5615

DEC 18 1977


Date	Material	Amount	Total	Date	Amount
7/28/77	Labor 36.70			6-28-77	160 00
	Police Duty <u>24.00</u>			12-13-77	14 89
	60.70			* Re-Land	143 11
	O.H. <u>6.07</u>	\$ 66 77			
	15' - 1" Copper @ 1.08	16 20			
1	1" Corporation	16.69			
1	1" Curb	20 54			
1	Box & Rod	13 41			
1	Hr. Trucking	3 00			
1	Hr. Shovel	6.50	\$ 143 11		
7/10/90	ADD 2'-1" COPPER 1"-CORP 1" Union				
				* Apply 757 to SHC #	

DATE _____

TOWN OF LEXINGTON — BOARD OF PUBLIC WORKS

WATER DIVISION

Sketch of Service Here

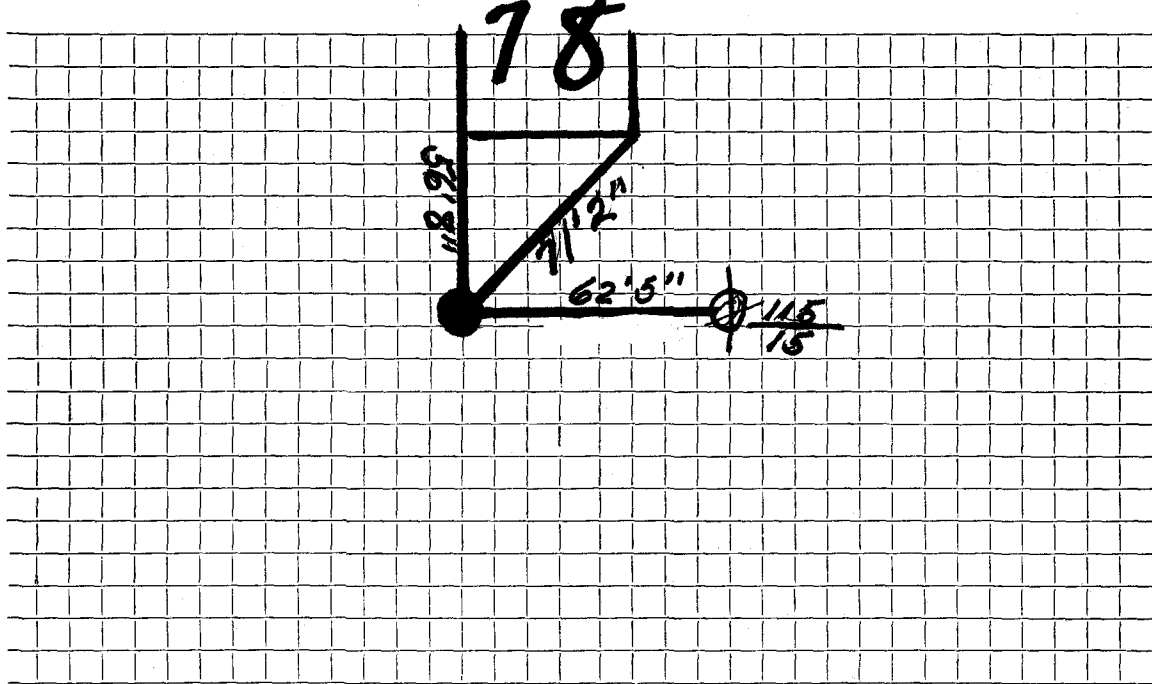

Connection made in Street. Work completed

Remarks:

.....

.....