




DATE \_\_\_\_\_

TOWN OF LEXINGTON — BOARD OF PUBLIC WORKS

WATER DIVISION

Sketch of Service Here

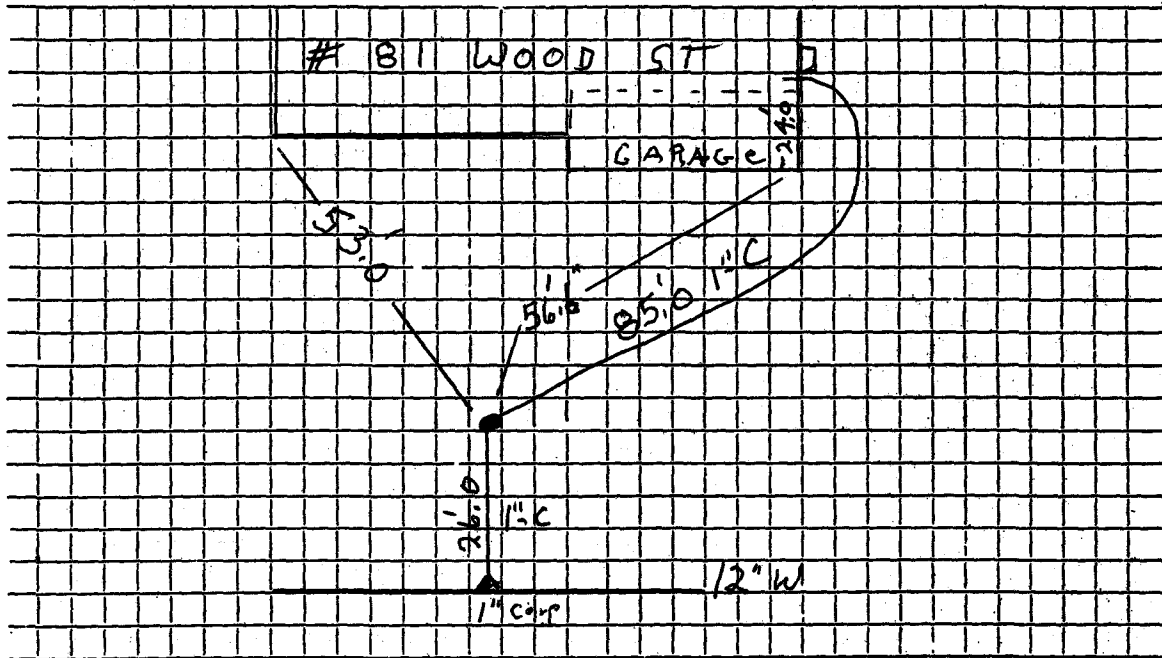

Connection made in ..... Street.

Work completed 6/4/07... J. McLaughlin.....

Remarks: .....  
.....  
.....