

WATER SERVICE RECORD

Name L.H.Hewett Jr., Inc.

Service No. 43

Address 90 Wood Street

Location

~~Renewal~~ - New Service Hewett #3496 W.O. #858

JUL 7 1980

Date	Material	Amount	Total	Date	Amount
12-6-79	Labor	26. <sup>68</sup>	29.35	10-31-79	150.00
	10% O.H.	2.67			59.70
	<del>10'-5"</del> 3/4" Copper tubing @.94		9.87		80.30
	1 <del>3/4"</del> Corp		12.40		
	1 <del>3/4"</del> Curb *		17.73		
	1 Box & Rod		10.95		
			80		
12-13-80	78' 3/4" Copper tubing				
7/23/90	10'-1" COPPER				
	1" CORP				
	1" CURB				
	1" X 3/4 Union				


*X Applied to W.O. #858*

DATE \_\_\_\_\_

# TOWN OF LEXINGTON — BOARD OF PUBLIC WORKS

## WATER DIVISION

Sketch of Service Here

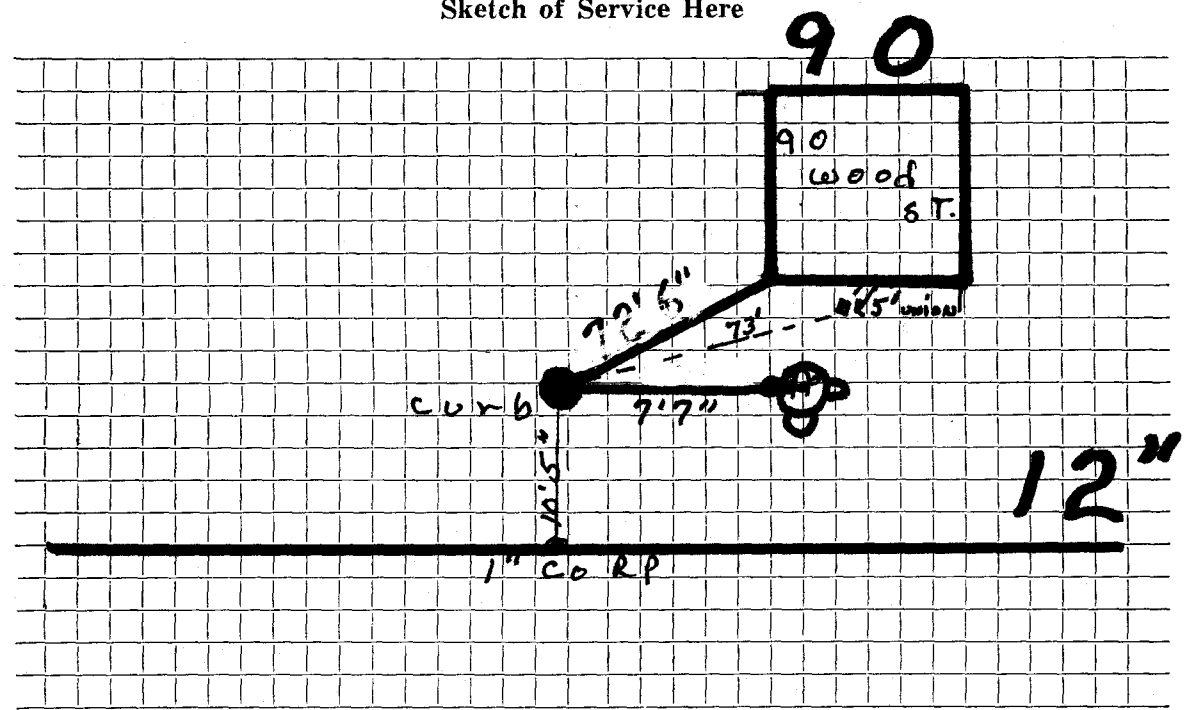

Connection made in ..... Street. Work completed .....

Remarks: *78' 3/4 Copp. inside 1 1/4 union*