

## WATER SERVICE RECORD

Name Lexington Housing Authority c/o Temple Scanlon

Service No. *40110*

Address 96 Wood St. Lexington, Mass.

Location

Repair—Renewal—New Service *WD #3867*


Date	Material	Amount	Total	Date	Amount
12/1/75	labor	22.40		<i>7-14-76</i>	<i>Deposit</i>
4/2/76	labor	39.00		<i>9-20-76</i>	<i>76</i>
4/27/76	labor	25.24	86.64		OUTSIDE
	10% OH	8.66	95.30	12/1/75	labor
57'	3/4" copper tubing @ .67		38.19	12	<del>3/4" copper @ .67</del>
1	3/4" wheel		14.53	1	<del>3/4" corp.</del>
1	3/4" union		4.69	1	<del>3/4" curb</del>
	Patch 22 X 9		132.00	1	box and rod
1 hr.	truck		3.00	2	tons cold patch @ 13.70
1/2 hr.	compressor @ 5.00		2.50		
1 1/2 hr.	shovel @ 6.50		9.75		
			299.96	<i>7/29/90</i>	
				<i>15'</i>	<i>1" COPPER</i>
					<i>1" CORP</i>
					<i>1" Curb</i>
					<i>1" X 3/4 Union</i>

DATE \_\_\_\_\_

TOWN OF LEXINGTON — BOARD OF PUBLIC WORKS

WATER DIVISION

Sketch of Service Here

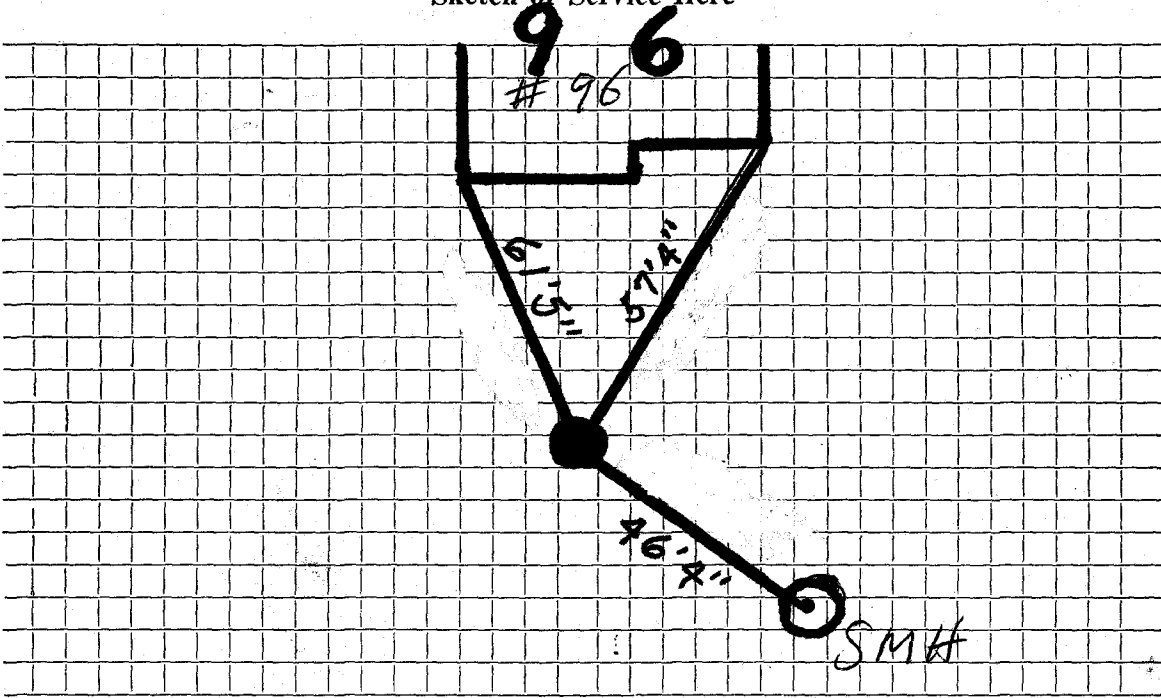

Connection made in ..... Street. Work completed .....

Remarks: .....  
.....  
.....