

Name Lexington Construction Co.

Service No. 27

Address 97 Wood Street

4637

Lexington, Mass.

Location 97 Wood Street

Kind of Pipe

Size

Size of Main

~~Water Service~~ New Service

Con. 5/22/50

Location

Date	Material	Amount	Total	Date	Amount
Apr. 3, '50	Labor	3 82	3 82	May 19 '50	65 00
	10% Overhead		38	May 25 '50	13 68
	53' - 3/4" Copper Tubing @.23	12 19			57 32
	1 - 3/4" C x 1/2" I.W.H. S&W	3 29			
	1 - 3/4" C x 3/4" C Union (3pts)	1 39		Apr. 3, '50	Labor 3 83
	Littlefield Shovel 1 1/2 hrs. @7.00	10 50		25' - 3/4" Copper Tubing @.23	5 75
	Trucking 1 hr. @.75	75		1 - 3/4" C Corp cock	3 15
	Patching 19 x 3	19 00		1 - 3/4" C x 3/4" C Curb-cock	3 85
			51 32	1 - Box & Rod	3 70
				1 - 1/2" Offset Tail Piece	38
				1 - 1/2" Straight Tail Piece	38
				Littlefield Shovel 1 1/2 hrs. @7.00	10 50
				Trucking 1 hr. @.75	75
	Labor			7/26/90	30' - 1" COPPER 32 29
					1" CORP
					1" CURB
					1" x 3/4 UNION

DATE _____

TOWN OF LEXINGTON - BOARD OF PUBLIC WORKS

WATER DIVISION

The undersigned applies for a supply of water at No..... St. and hereby agrees to comply with the rules and regulations as now, or at any future time, established by the Board of Selectmen.

Am't of Estimate \$.....


Owner

Am't Paid \$.....

Address

Builder

Sketch of Service Here

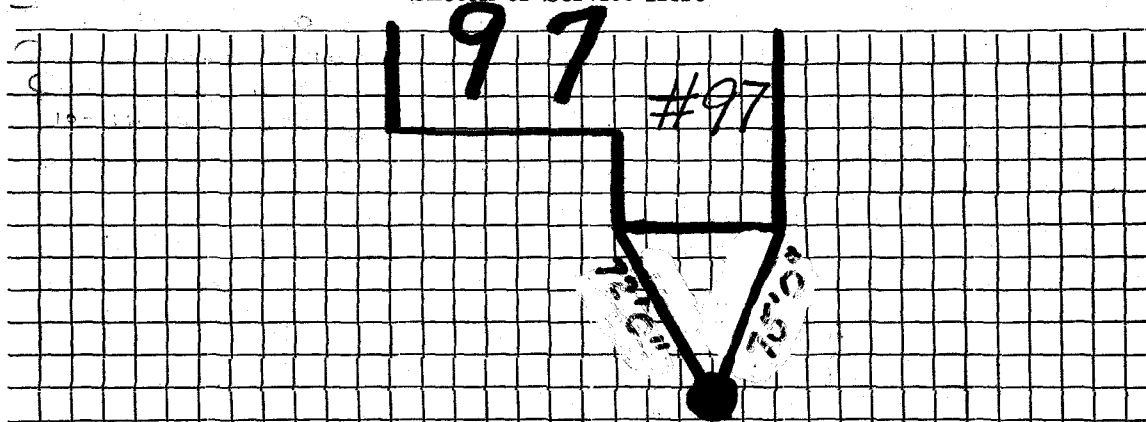

Connection made in Street.

Work completed19

Remarks: