


DATE _____

TOWN OF LEXINGTON — BOARD OF PUBLIC WORKS

WATER DIVISION

Sketch of Service Here
Building #110

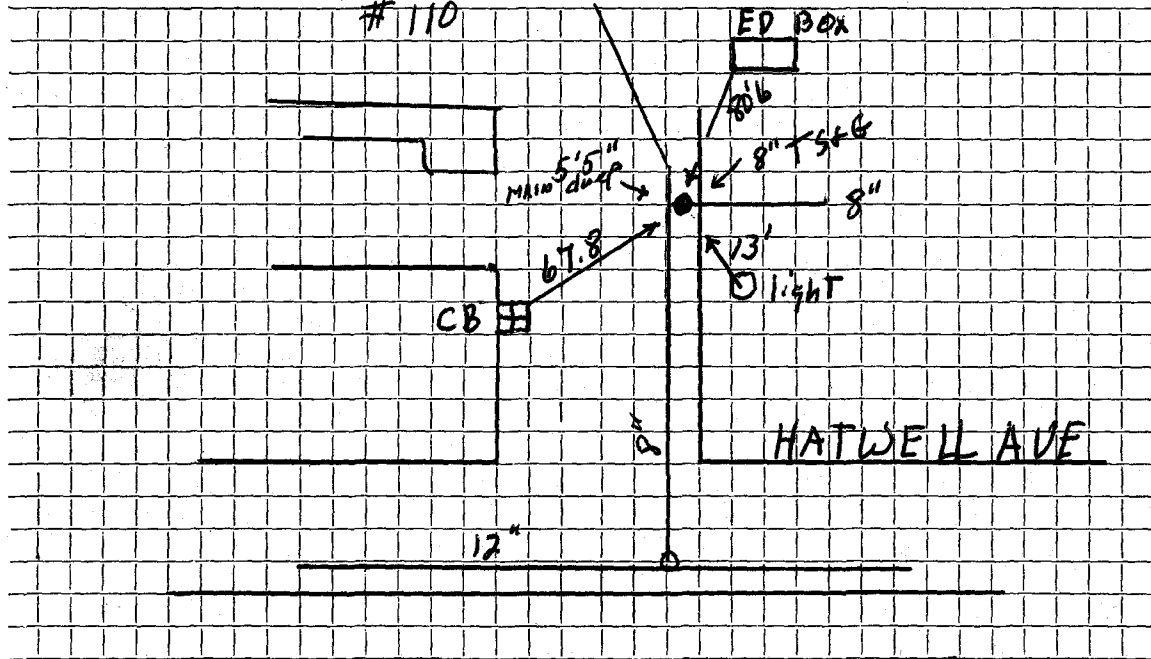

Connection made in Street. Work completed

Remarks:

.....

.....