


TOWN OF LEXINGTON — BOARD OF PUBLIC WORKS

WATER DIVISION

Sketch of Service Here

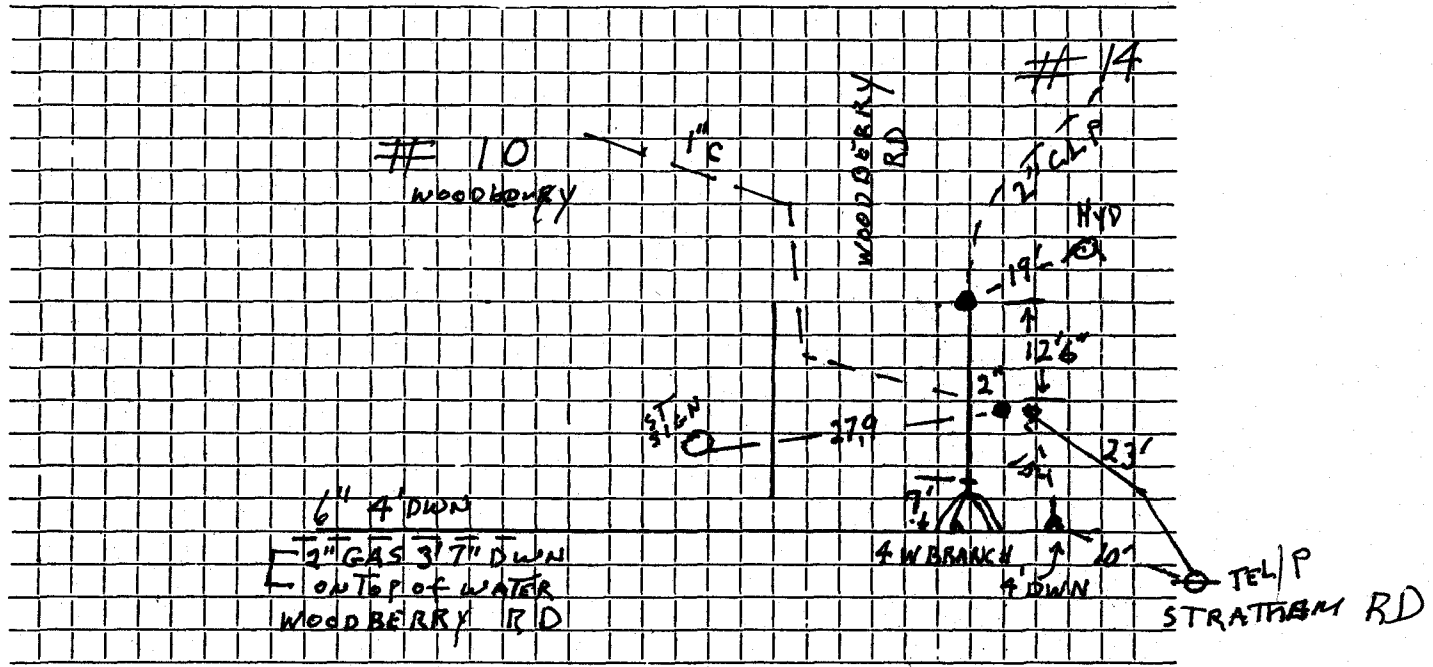

Connection made in Street. Work completed JUNE 8/98

Remarks: INS.P. BY ENG. TAKE CURB TO HOUSE

NEW 1" COPPER DOWN LEFT SIDE DRIVEWAY