


DATE _____

TOWN OF LEXINGTON — BOARD OF PUBLIC WORKS
WATER DIVISION

Sketch of Service Here

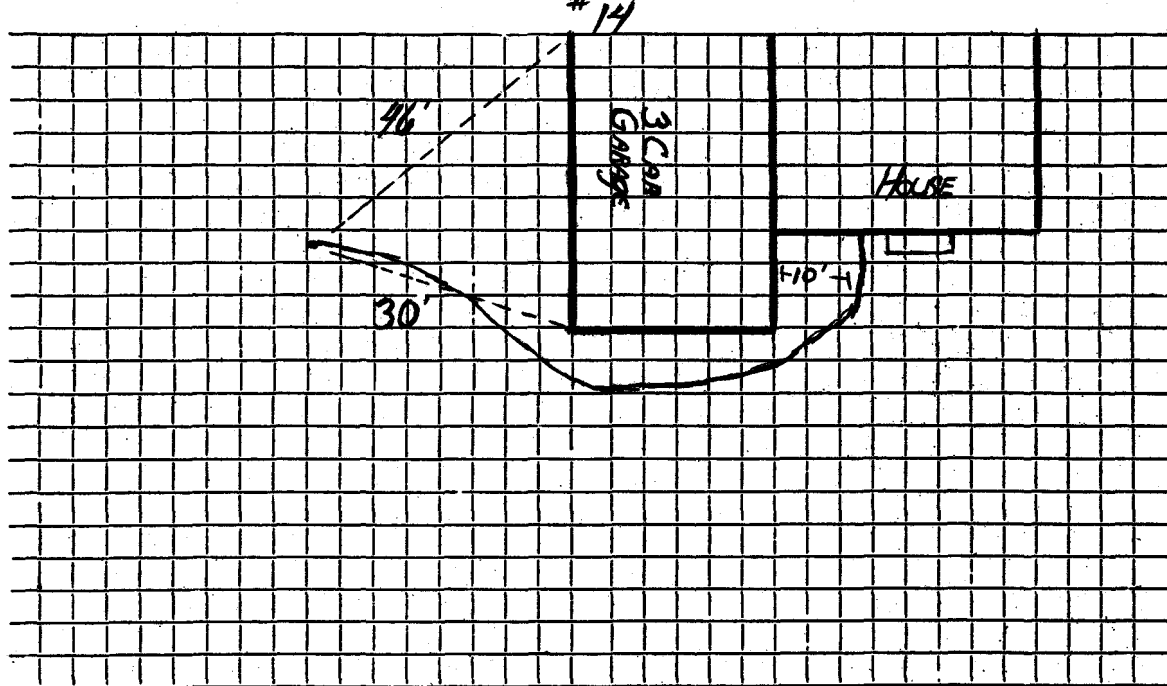

Connection made in Street. Work completed

Remarks: ... CURB IS IN DRIVEWAY

.....
.....

WATER SERVICE RECORD

Name Mrs. T. James Brown

Service No. 253 & 259

Address 14 Woodberry Road

Location

~~XXXXXXXXXX~~ - New Service

Conn. 12-13-54

*OLD +
NEW*

Date	Material	Amount	Total	Date	
10/19/54	Labor	47 97		10-13-54	Deposit
10/20/54	"	90 88		10-18-54	"
10/21/54	"	93 25		10-29-54	Paid
10/22/54	"	87 96			
10/26/54	"	39 85			
10/27/54	"	41 70	401 61	10/19/54	Labor
	10% overhead		40 16		
	504' -2" C.L. pipe @ .8510		428 90	21' - 2" C.L. pipe @ .8510	
	1 - 2" W.H. gate valve		18 60	30' - 1" copper tubing @ .4956	
	40 lbs. dynamite @ .25		10 00	4 - 1" C. corp-cocks @ 5.61	
	62 exploders @ .1585		9 82	1 - 2" I x 1" C. 4 way branch	
	11 hrs. #36 compressor @ 2.75		30 25	1 - 2" gate valve	
	4 hrs. #37 compressor @ 1.75		7 00	1 gate box	
	18 hrs. town shovel @ 5.00		90 00	2 hrs. town shovel @ 5.00	
	8 hrs. trucking @ .75		6 00	2 hrs. trucking @ .75	
			1042 34		

10 42 34

NON CHARGE


PART OF TRENCH DUG BY OWNER:

Bill sent 12-14-54

TOWN OF LEXINGTON — BOARD OF PUBLIC WORKS

WATER DIVISION

Sketch of Service Here

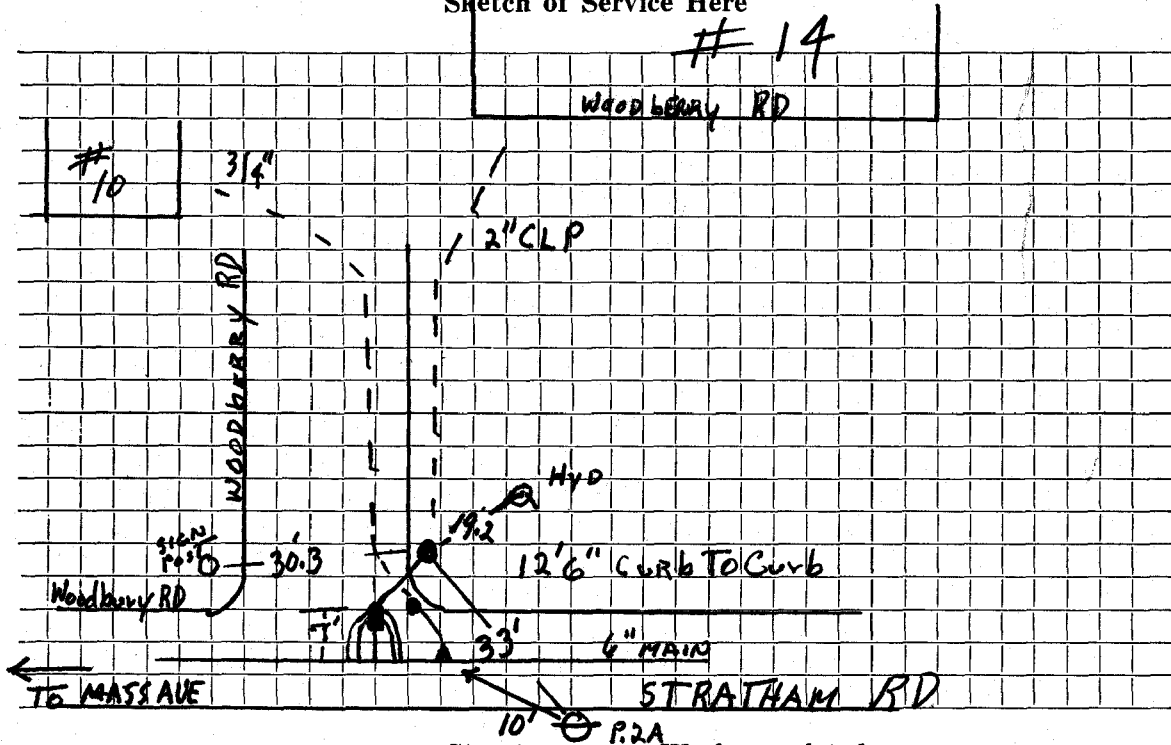

Connection made in Street. Work completed

Remarks: 2" GAS ON TOP OF WATER MAIN DWN 3'4"

..... WATER MAIN DWN 4'

WATER SERVICE RECORD

Name Mrs. T. James Brown

Service No. 253 & 259

Address 14 Woodberry Road

Location

~~XXXXXXXXXXXX~~—New Service


Com. 12-13-54

Date	Material	Amount	Total	Date	Amount
10/19/54	Labor	47 97		10-13-54 Deposited	330 00
10/20/54	"	90 88		10-18-54 "	300 00
10/21/54	"	93 25		12-29-54 Paid	192 34
10/22/54	"	87 96			1042 34
10/26/54	"	39 85			
10/27/54	"	41 70	401 61	10/19/54 Labor	40 00
	10% overhead		40 16	21' - 2" C.L. pipe @ .8510	17 87
	504' - 2" C.L. pipe @ .8510		428 90	30' - 1" copper tubing @ .4956	14 87
	1 - 2" W.H. gate valve		18 60	4 - 1" C. corp-cocks @ 5.61	22 44
	40 lbs. dynamite @ .25		10 00	1 - 2" I x 1" C. 4 way branch	19 38
	62 exploders @ .1585		9 82	1 - 2" gate valve	19 15
	11 hrs. #36 compressor @ 2.75		30 25	1 gate box	11 55
	4 hrs. #37 compressor @ 1.75		7 00	2 hrs. town shovel @ 5.00	10 00
	18 hrs. town shovel @ 5.00		90 00	2 hrs. trucking @ .75	1 50
	8 hrs. trucking @ .75		6 00		156 76
			1042 34		
	PART OF TRENCH DUG BY OWNER:				
				Bill sent 12-14-54	

TOWN OF LEXINGTON — BOARD OF PUBLIC WORKS

WATER DIVISION

Sketch of Service Here

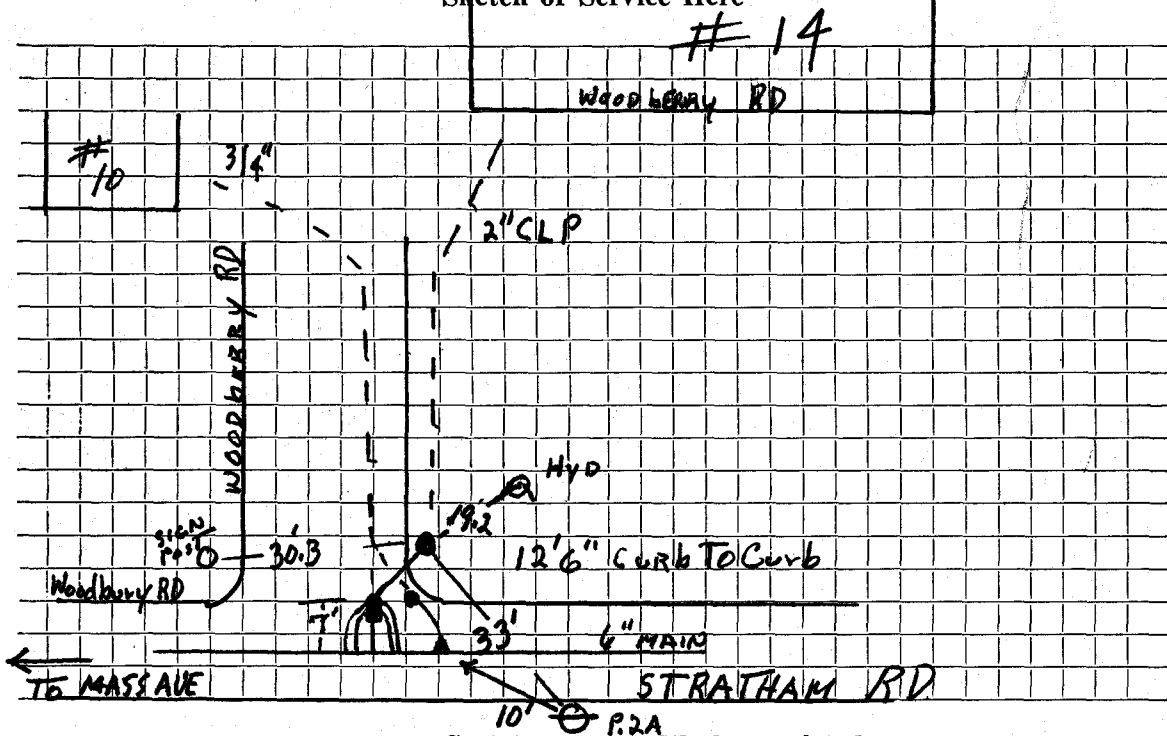

Connection made in Street. Work completed

Remarks: 2" GAS ON TOP OF WATER MAIN DWN 3'4"

..... WATER MAIN DWN. 4'

WATER SERVICE RECORD

Name ANDERSON

Service No.

Address 14 WOODBERRY RD

Location

Repair—Renewal—New Service DEVINE

Date	Material	Amount	Total	Date	ARLEX	Amount
11/17/78	OWNER SUPPLIED MATERIAL			11/30/99		
	8' 1 1/2" COPPER				168' 1 1/2" COPPER	
	1 8" x 1 1/2" SERVICE SADDLE				6' 1" COPPER	
	1 1 1/2" CORP				17' 1" COPPER UNDER GARAGE FLOOR	
	1 1 1/2" CURB				2 1 1/2" UNIONS	
	PLASTIC CURB BOX				1 1 1/2" x 1" UNION	
					1 1 1/2" CURB STOP	
					1 GATE BOX (IN UNIONS)	

