


DATE 10/28/19

TOWN OF LEXINGTON — BOARD OF PUBLIC WORKS

WATER DIVISION

Sketch of Service Here

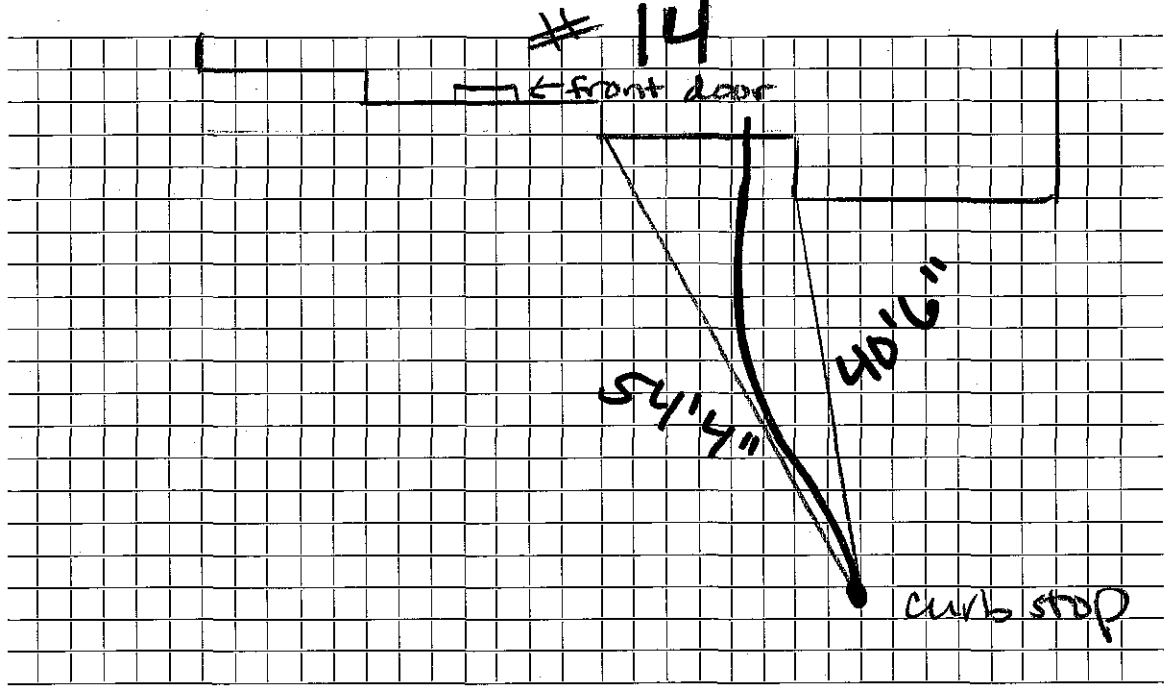

Connection made in Waldcliffe Rd Street

Work completed

Remarks: