

## WATER SERVICE RECORD

Service No. 25

Name John Viano

Address 15 Woodcliffe Road

Location

~~REPAIR~~ - New Service

Com. 4-11-55


Date	Material	Amount	Total	Date	Amount
3/15/55	Labor	6 90		2-28-55	Deposited 100 00
	10% overhead	69	7 59	4-11-55	Refunded 12 44
	90' - 3/4" copper tubing @ .35		31 50		<u>NON CHARGE</u> 87 56
	1 - 3/4" C x 1/2 I.W.H. stop & waste	4 00		3/15/55	Labor 6 90
	1 - 3/4" C. Union		1 72	16' - 3/4" copper tubing @ .35	5 60
	4 hrs. Littlefield shovel @ 7.50	30 00		1 - 3/4" C. corp-cock	4 33
	1 hr. trucking		75	1 - 3/4" C. curb-cock	4 67
	patching 12 x 3		12 00	1 box and red	3 90
4-27-61	Repair		87 56	1 - 1/2 straight tail pc.	50
	6' 3/4" Copper			1 - 1/2 offset tail pc.	50
	2 3/4" C. 3 Part UNIONS			1 hr. Littlefield shovel	7 50
				1 hr. trucking	75
10/98	SERVICE LOWERED INSIDE DT				34 65

DATE \_\_\_\_\_

TOWN OF LEXINGTON — BOARD OF PUBLIC WORKS

WATER DIVISION

Sketch of Service Here

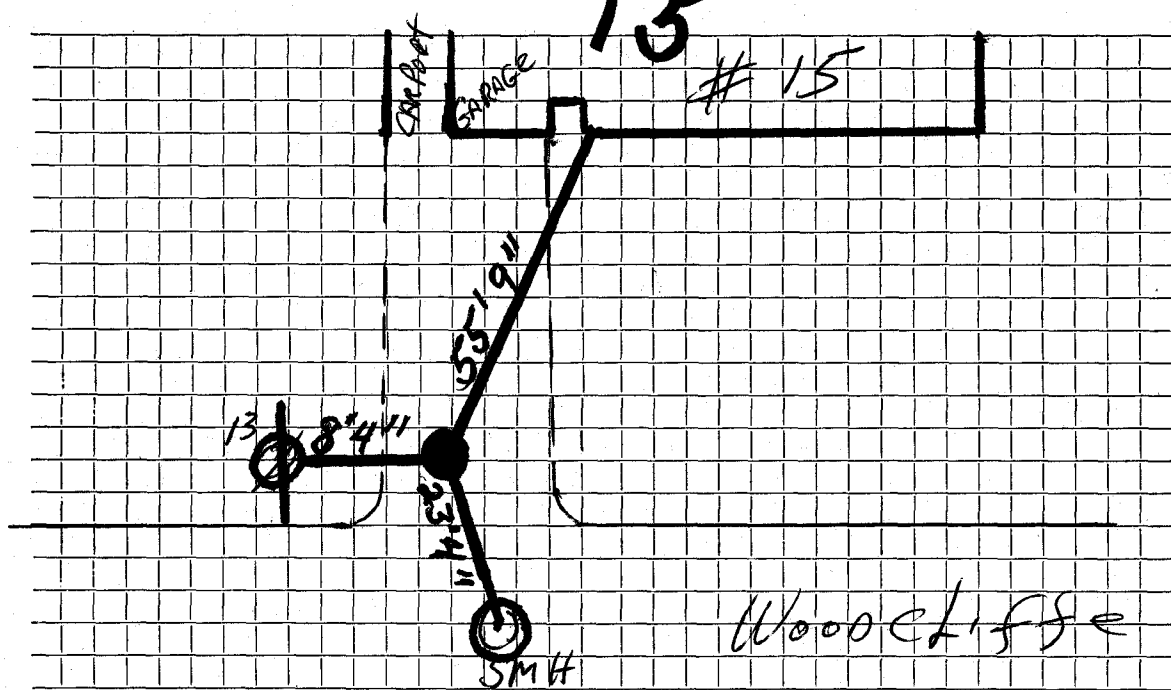

Connection made in ..... Street. Work completed .....

Remarks: .....  
.....  
.....