




DATE 8/8/18

TOWN OF LEXINGTON — BOARD OF PUBLIC WORKS

WATER DIVISION

Sketch of Service Here

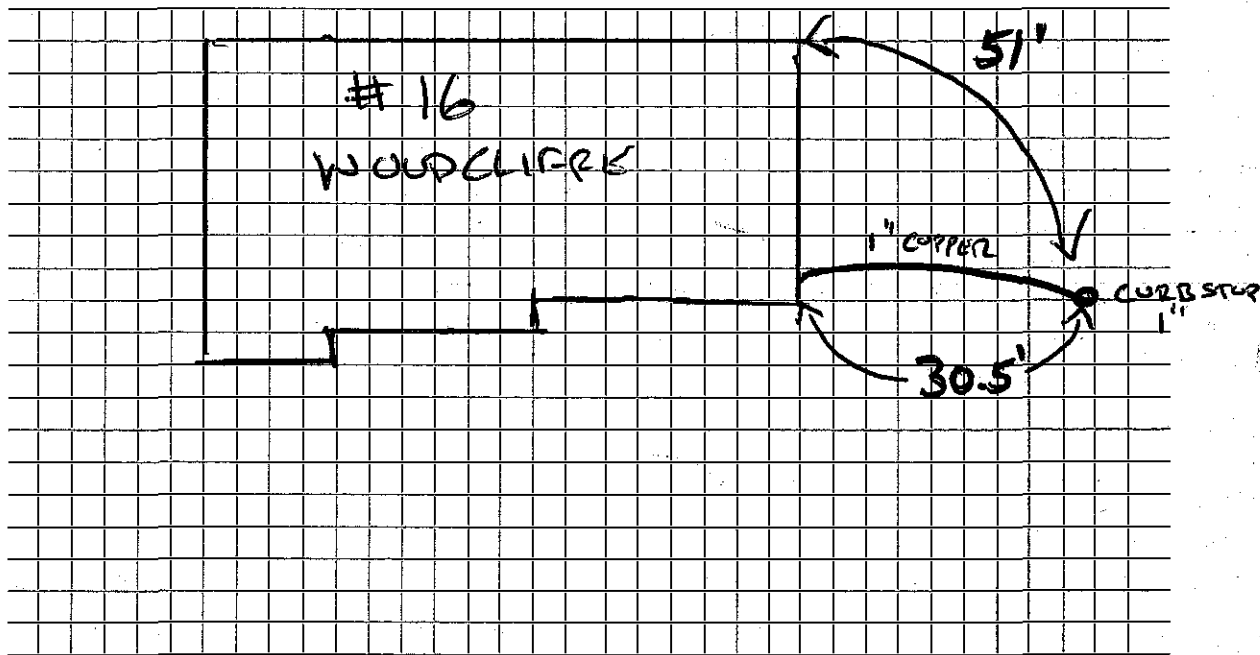

Connection made in... 16 WOODCLIFFE Street. Work completed .....

Remarks: 1" CURB STOP (NEW)