

Name Custom Built Homes

Service No. 11569

Address 19 Woodcliffe Road

5843

Lexington, Mass.

Location 19 Woodcliffe Road

6233

Kind of Pipe

Size

Size of Main

~~Repair~~ ~~Renewal~~ New Service

Com. 6-14-49

Location

Date	Material	Amount	Total	Date	Amount
May 9, '49	Labor	4 00	4 00	May 30 '49	30 00
	10% Overhead		40		
	58' - 3/4" Copper Tubing @.27		15 66		Non-Charge
	1 - 5/4" C x 1/2" I.W.H. S&W		3 29	May 9, '49	Labor 4 05
	2 - 5/4" C x 5/4" C Union (3 pts)		2 78		16' - 5/4" Copper Tubing @.27 4 32
	Trucking 1 hr. @.75		75		1 - 5/4" C Corp-cock 3 15
			26 88		1 - 5/4" C x 5/4" C Curb-cock 3 85
					1 - Box & Rod 3 95
					1 - 1/2" Straight Tail Piece 37
					1 - 1/2" Offset Tail Piece 37
					Littlefield Shovel 1 hr. @7.00 7 00
					Trucking 1 hr. @.75 75
	Labor				27 81

DATE _____

TOWN OF LEXINGTON - BOARD OF PUBLIC WORKS

WATER DIVISION

The undersigned applies for a supply of water at No..... St. and hereby agrees to comply with the rules and regulations as now, or at any future time, established by the Board of Selectmen.

Am't of Estimate \$.....


Owner

Am't Paid \$.....

Address

Builder

.....

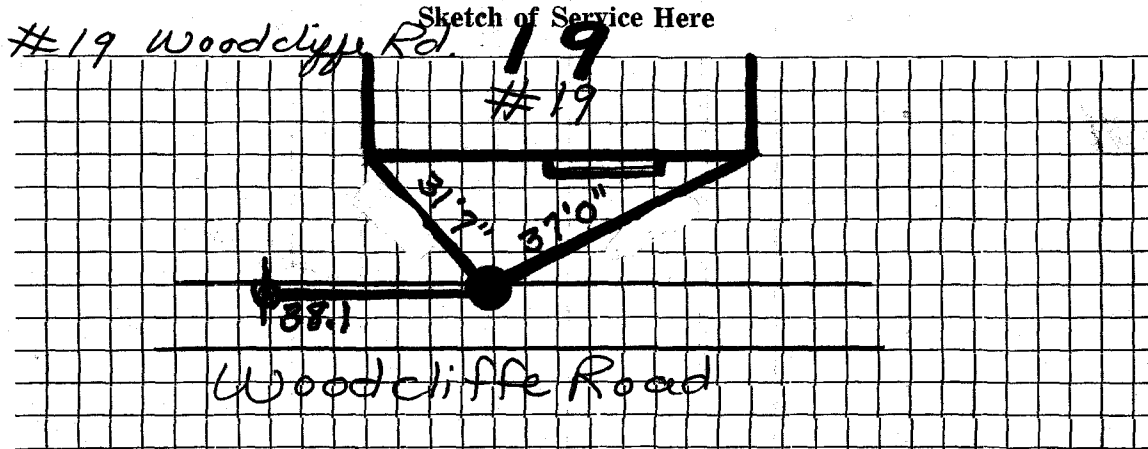

Connection made in Street.

Work completed19

Remarks: