

Name Custom Built Homes

Service No.

41

Address 22 Woodcliffe Road

Lexington, Mass.

Location 22 Woodcliffe Road

Kind of Pipe

Size

Size of Main

~~Repair~~ New Service Com. 6-11-49

Location

Date	Material	Amount	Total	Date	Location	Amount
May 9, '49	Labor	4.00	4.00	May 30 '49	Reported	30.00
	10% Overhead		40			
	59' - $\frac{3}{4}$ " Copper Tubing @.27		15.93		Non-Charge	
	1 - $\frac{3}{4}$ " C x $\frac{1}{2}$ " I.W.H. S&W		3.29	May 9, '49	Labor	4.05
	1 - $\frac{3}{4}$ " C x $\frac{3}{4}$ " C Union (3 Pts)		1.39	30' - $\frac{3}{4}$ " Copper Tubing @.27		8.10
	Trucking 1 hr. @.75		75	1 - $\frac{3}{4}$ " C Corp-cock		3.15
			25.76	1 - $\frac{3}{4}$ " C x $\frac{3}{4}$ " C Curb-cock		3.85
				1 - Box & Rod		3.95
				1 $\frac{1}{2}$ " Straight Tail Piece		37
				1 - $\frac{1}{2}$ " Offset Tail Piece		37
				Littlefield Shovel 1 hr. @7.00		7.00
				Trucking 1 hr. @.75		75
	Labor					31.59

DATE _____

TOWN OF LEXINGTON - BOARD OF PUBLIC WORKS

WATER DIVISION

The undersigned applies for a supply of water at No..... St. and hereby agrees to comply with the rules and regulations as now, or at any future time, established by the Board of Selectmen.

Am't of Estimate \$.....

Owner


Am't Paid \$.....

Address

Builder

.....

Sketch of Service Here

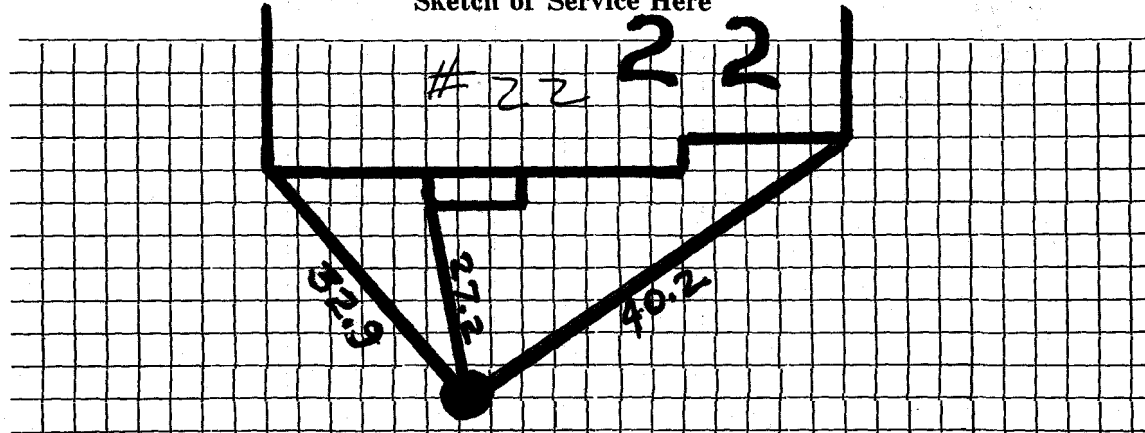

Connection made in Street.

Work completed19

Remarks: